


DEPTH (m)	SAMPLE TYPE	SAMPLE ID	SPT COUNT	SOIL TYPE	SOIL DESCRIPTION	FIELD TEST DATA					WELL COMPLETION	WATER LEVEL	WELL COMPLETION NOTES	ELEVATION (m)
						ORGANIC VAPOUR LEVEL (ppmv)								
						1	10	100	1000	10000				
0.0 - 0.3				SAND AND GRAVEL	trace to some silt, compact, brown, dry							Roadbox & concrete		
0.3 - 1.1				SAND	fine to medium grained, some gravel, compact, grey, moist moderate hydrocarbon odour from 1.1 to 1.2 m			660				Bentonite seal		
1.1 - 2.0				SAND AND GRAVEL	compact, black, wet			550				Backfilled with silica sand	98	
2.0 - 3.0				SAND AND GRAVEL	compact, black, wet			75				GW = 97.13 m (Dec 19/02)	97	
3.0 - 3.4				SAND AND GRAVEL	10 cm fine grained sand lens at 3.0 m			50					96	
3.4 - 4.6				SAND AND GRAVEL				55				Slough	95	
4.6					End of borehole at 4.6 m									
					50 mm diam, 010 slot, PVC monitoring well installed Screened interval = 1.2 to 3.4 m									
					Top of Piezometer (TOP) elevation = 98.92 m Depth to groundwater from TOP = 1.80 m (Dec 19/02) Groundwater elevation = 97.13 m (Dec 19/02) Borehole combustible vapour level = >10000 ppmv (Dec 19/02)									

SEACOR CANADA V5
GPJ SEACOR CANADA V5.GDT 12/31/03


DRILLING METHOD: Hollow Stem Auger

Notes:  SPLIT SPOON

DRILL DATE: August 30, 2002

LOGGED BY: LP

Sheet 1 of 1

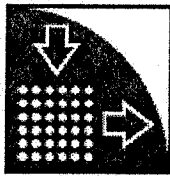

Seacor Environmental Inc.

#200-1620 West 8th Avenue

Vancouver, B.C., Canada

Slug test analysis

No: 204.10029

Project: Lumby IOL

Client: Imperial Oil Ltd.

Location: Lumby, B.C.

Slug test: BH2 Slug#1

Test well: BH2

Test performed by: A. Michener


Evaluated by: NCR

Test date: 28/11/2003

Evaluation date: 06/12/2003

Analysis method: BOUWER & RICE

Aquifer thickness: 4.17

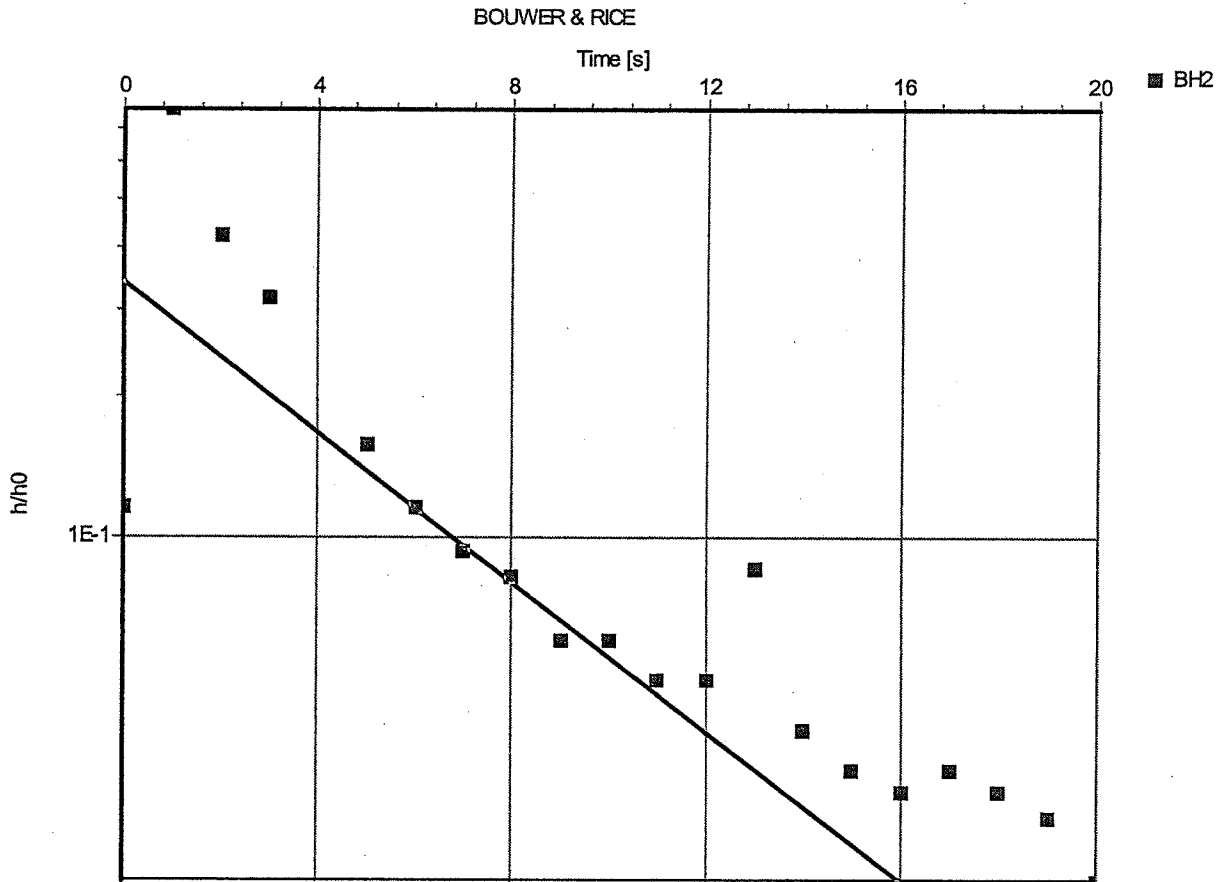

Conductivity: 2.70×10^{-4} [m/s]