



SNC-LAVALIN
Environment

Client :
Shell Canada Products

Borehole No. : 09-58DD

Location :
No. 3 Road & Granville, Richmond, BC


(Page 1 of 1)

Drilling Contractor: Uniwide Drilling Co. Ltd.
Drilling Method : Solid Stem Auger/Hollow Stem Auger
Borehole Dia. (m) : 0.20
Pipe/Slotted Pipe Dia. (m) : 0.05, 0.05

Date Monitored : 2009 06 19
Ground Surf Elev. (m) : 9.946
Top of Casing Elev. (m) : 10.519

Project Number : 130932
Borehole Logged By : PEO
Date Drilled : 2009 06 16
Log Typed By : MAL

Depth in Metres	Drilling Legend	Water/NAPL Levels	Straigraphy Plot	Sample Interval/ Core Run	Sample Number	Blow Count	% Recovery	Soil Vapour (ppm)				Well Name: MW09-58DD
	<ul style="list-style-type: none"> Sample Interval Auger Flight 	<ul style="list-style-type: none"> Water Level 1 Water Level 2 NAPL NAPL 						<ul style="list-style-type: none"> Reading within indicated scale Reading outside indicated scale 	1	2	3	
0	SAND and GRAVEL (ROADBASE), medium to coarse grained sand, coarse gravel, subangular, brown, dense, damp. Below 0.3 m - PEA GRAVEL (FILL), some medium to coarse grained sand, brown, loose, moist, hydrocarbon-like odour.											
1	SAND, fine to medium grained, some silt, black, medium dense, moist, hydrocarbon-like odour.											
2	SILT, grey, soft, wet, hydrocarbon-like odour.											
3	SAND, fine to medium grained, trace silt, grey, medium dense, wet, hydrocarbon-like odour.											
4	Below 4.1 m - no silt.											
5	Below 4.9 m - hydrocarbon-like odour.											
6	End of borehole at 6.7 m.											
7												
8												
9												
10												

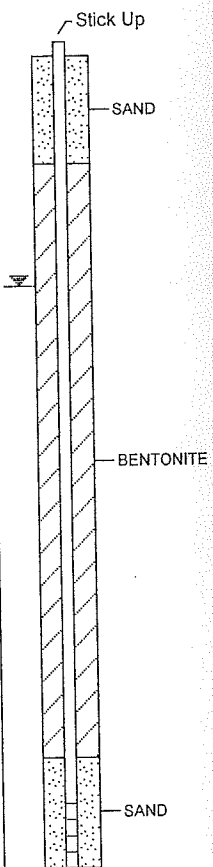

Print Date: 2010 02 17, Date Approved: 2009 07 16

Notes: