


NORTH DOUGLAS DISTRIBUTION		CONTRACTOR: BECK DRILLING & ENVIRONMENTAL	BOREHOLE NO: BH004
DETAILED SITE INVESTIGATION		TYPE: SOLID STEM AUGER	PROJECT NO: NX20283
602 BARBON PLACE, VICTORIA, B.C.			ELEVATION: 98.78 m
SAMPLE TYPE	<input checked="" type="checkbox"/> GRAB	<input checked="" type="checkbox"/> SPLIT SPOON	
BACKFILL TYPE	<input checked="" type="checkbox"/> BENTONITE	<input type="checkbox"/> PEA GRAVEL	<input type="checkbox"/> SLOUGH
		<input type="checkbox"/> GROUT	<input checked="" type="checkbox"/> DRILL CUTTINGS
			<input type="checkbox"/> SAND FILTER PK

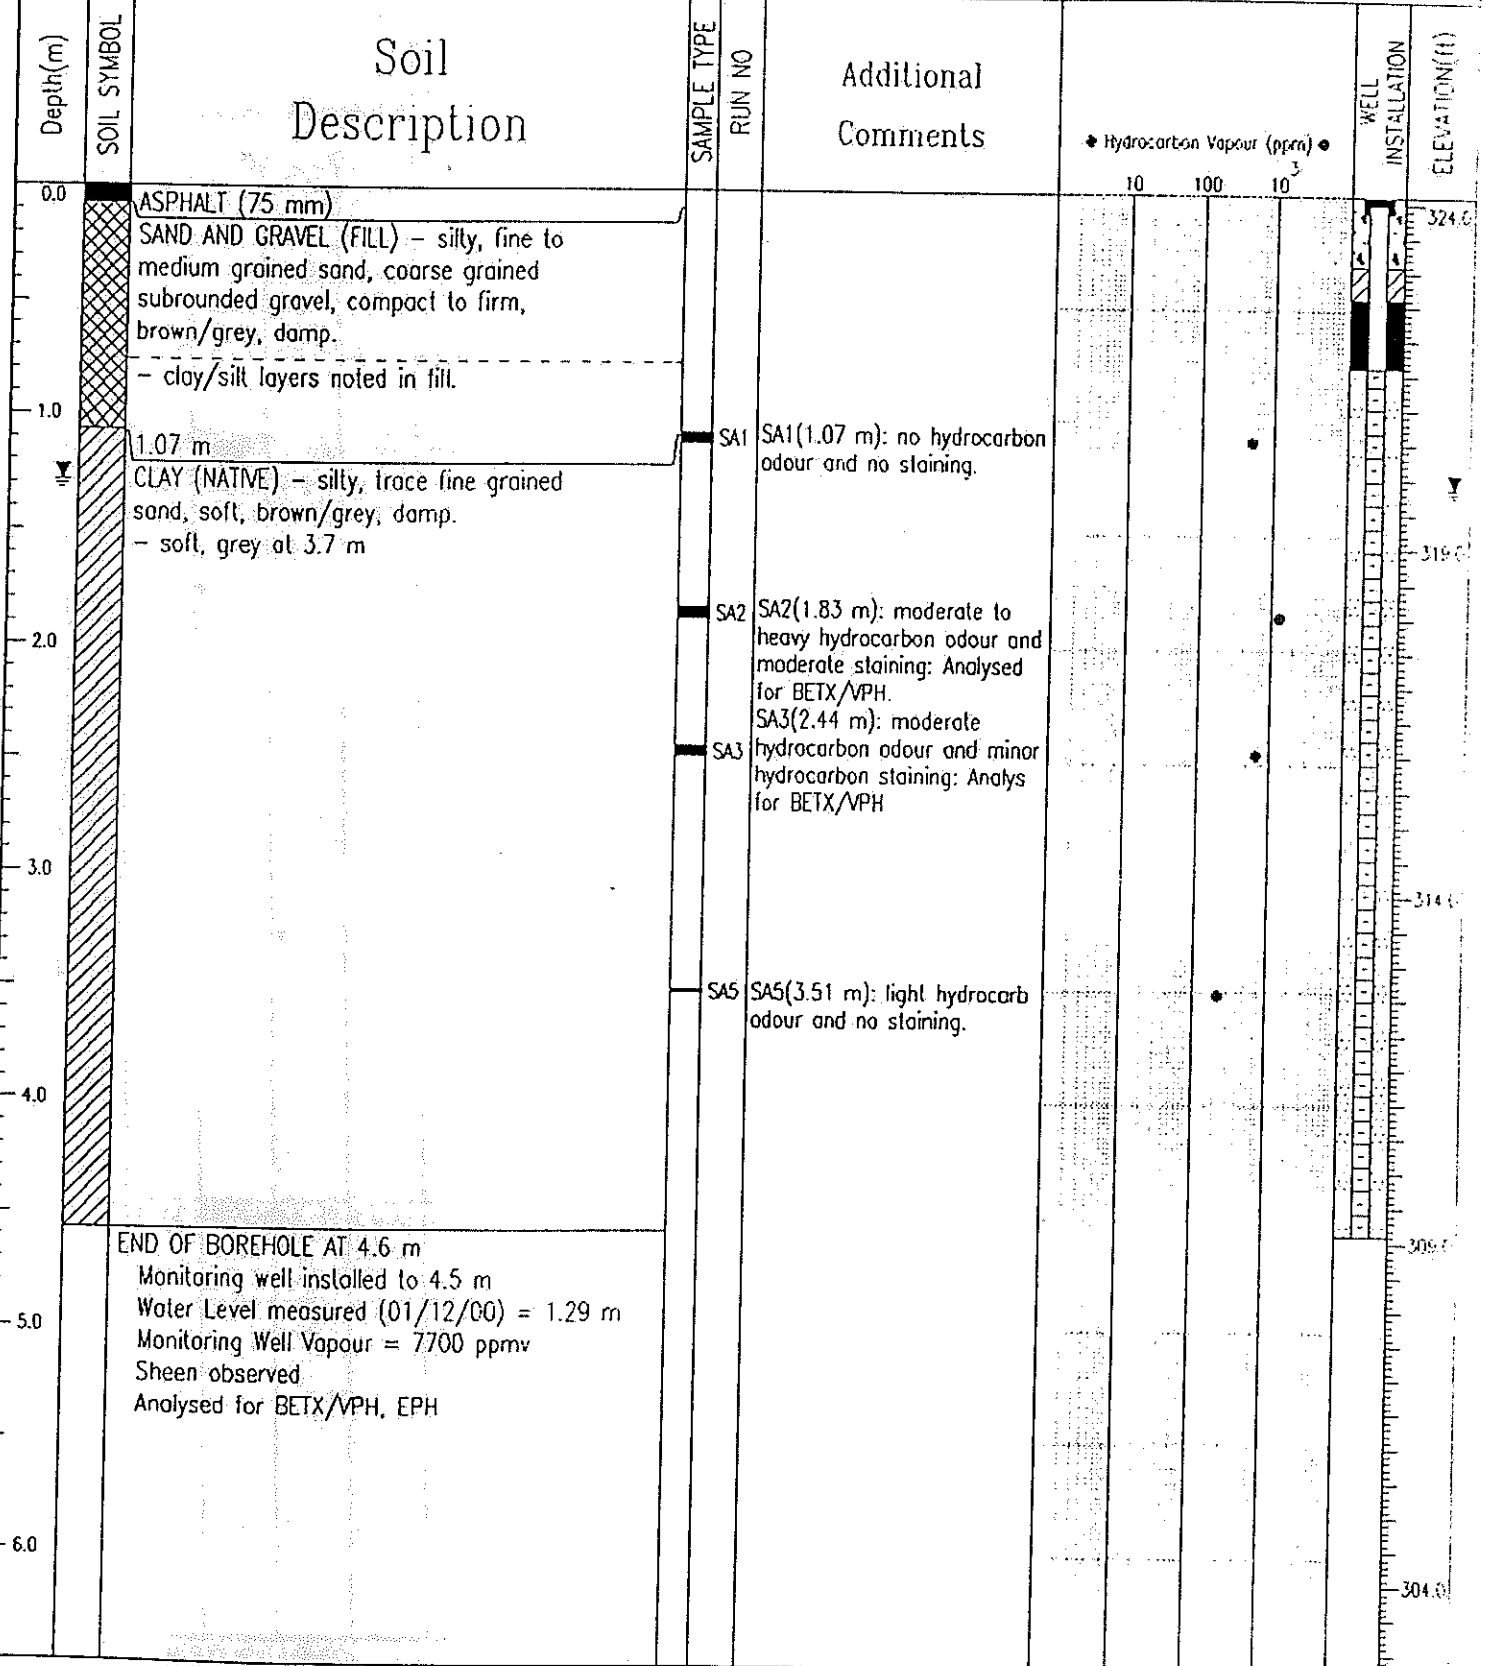

AMEC Earth & Environmental Limited	LOGGED BY: EG	COMPLETION DEPTH: 4.572 m
	REVIEWED BY: CT	COMPLETE: 30/11/00
	Fig. No: 1	Page 1 of 1

00/12/12 09:56:44 (EXPORT)