


PROJECT: Western Steel Remed Advice	CLIENT: Mitchell Island Holdings Inc.	TESTHOLE NO: MW14-21
LOCATION: 5452261 E 491909 N		PROJECT NO.: 60147906
CONTRACTOR: Blue Max Environmental Drilling Inc	METHOD: Solid Stem Auger/Direct Push	ELEVATION (m): 3.52
SAMPLE TYPE	<input type="checkbox"/> GRAB <input type="checkbox"/> SHELBY TUBE <input type="checkbox"/> SPLIT SPOON <input type="checkbox"/> BULK	<input type="checkbox"/> NO RECOVERY <input type="checkbox"/> CORE
BACKFILL TYPE	<input type="checkbox"/> BENTONITE <input type="checkbox"/> GRAVEL <input type="checkbox"/> SLOUGH <input type="checkbox"/> GROUT	<input type="checkbox"/> CUTTINGS <input type="checkbox"/> SAND

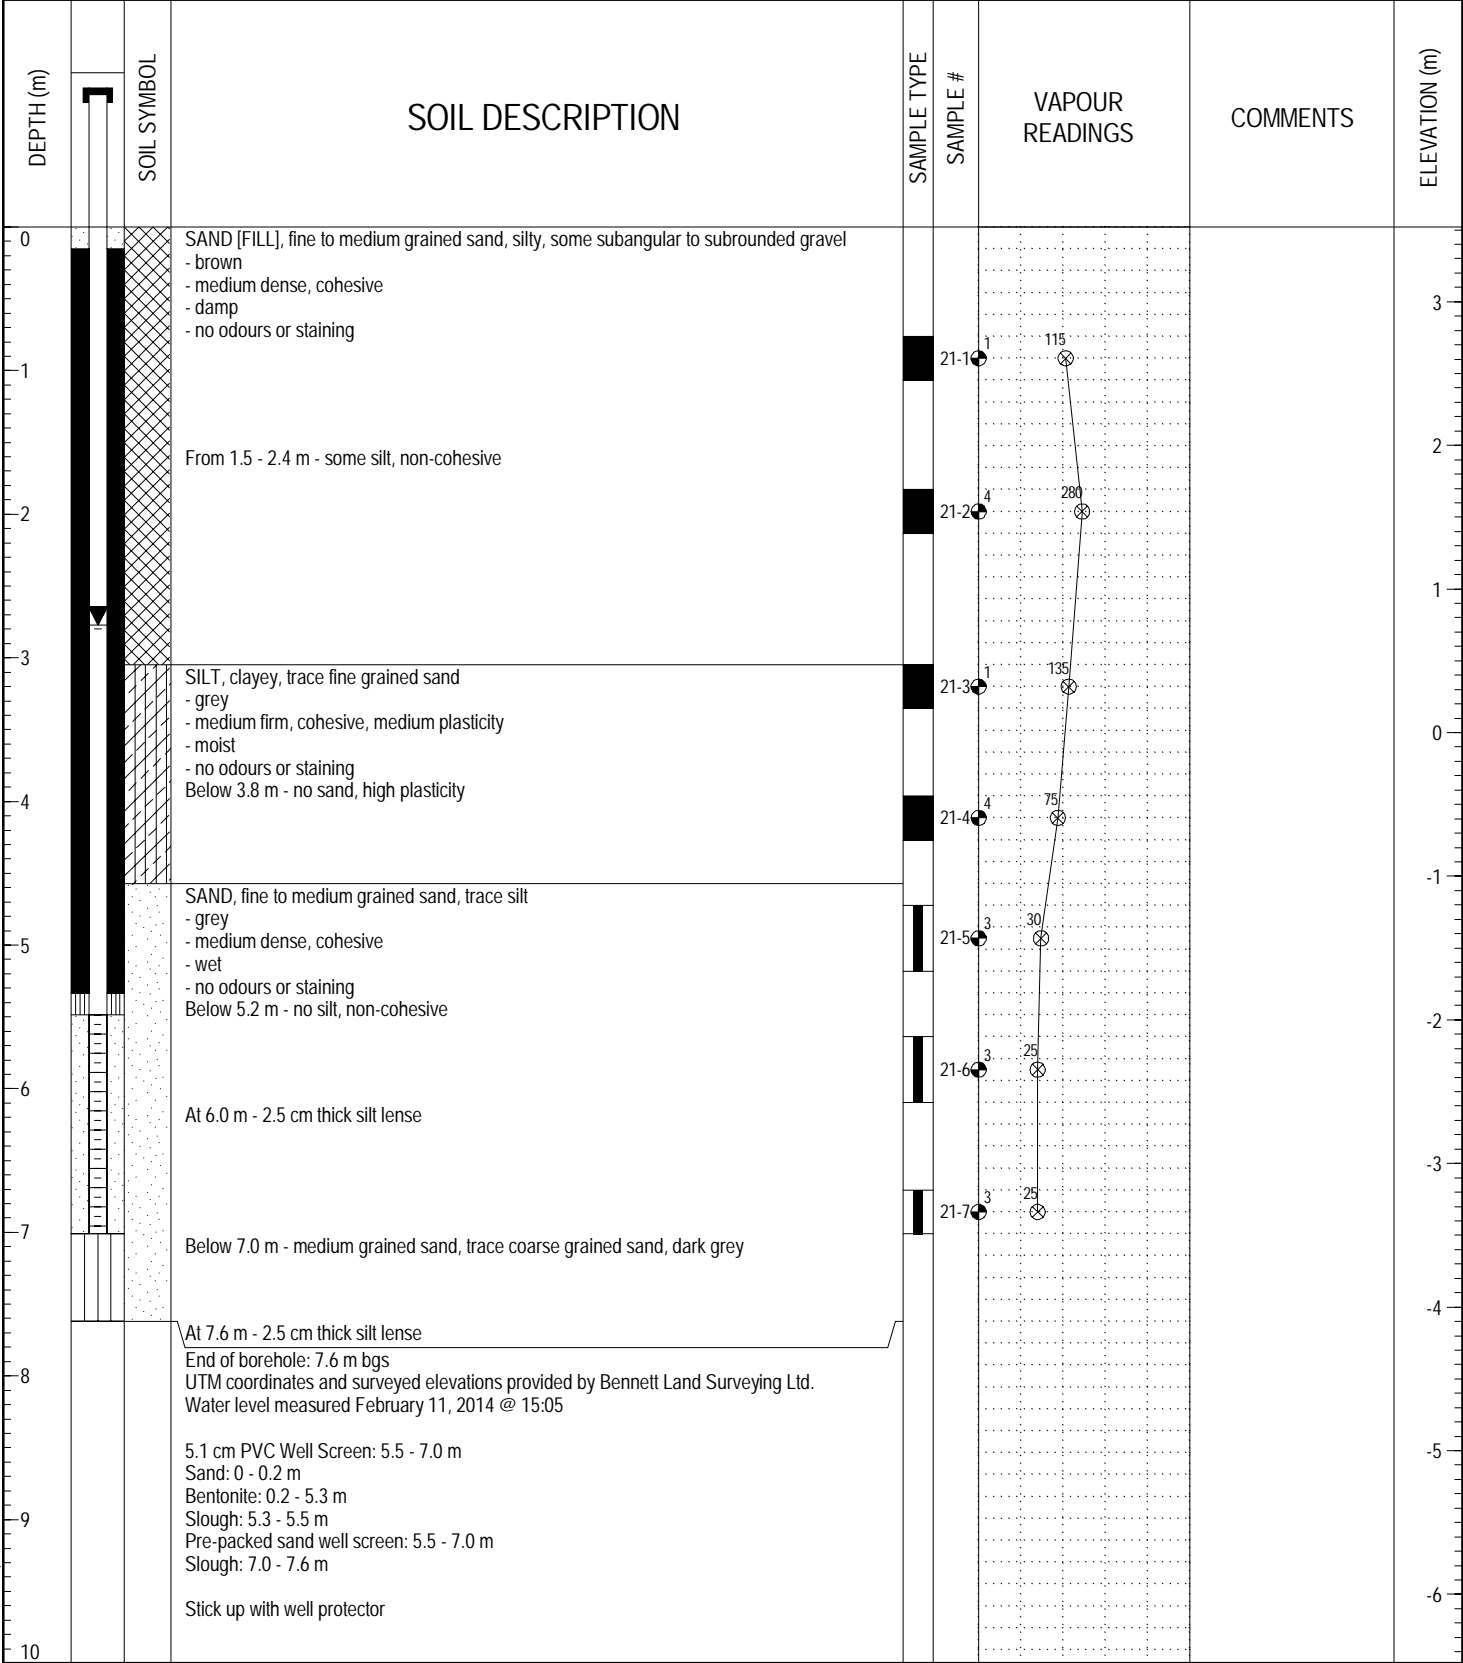

ENVIRO (VAPOUR/F2/F3) WESTERN STEEL.GPJ UMA.GDT 3/26/14



LOGGED BY: CH	COMPLETION DEPTH: 7.62 m
REVIEWED BY: LB	COMPLETION DATE: 1/22/14
PROJECT ENGINEER: RD	Page 1 of 1

For environmental purposes only