



Client :
Canadian Pacific Railway

Borehole No. : 03-9

Location :
Port Coquitlam Yard West


(Page 1 of 1)

Drilling Contractor: Uniwide Drilling Co. Ltd.
Drilling Method : Solid Stem Auger/Hollow Stem Auger
Borehole Dia. (m) : 0.20
Pipe/Slotted Pipe Dia. (m): 0.05, 0.05

Date Water Lev. Meas. : 2003 12 22
Ground Surf Elev. (m) : 10.3
Top of Casing Elev. (m) : 10.243

Project Number : V033185
Borehole Logged By : ICH
Date Drilled : 2003 09 03
Log Typed By : SGP

Depth in Metres	Drilling Legend		Water/LPH Levels		Stratigraphy Plot	Sample Interval/ Core Run	Sample Number	Blow Count	% Recovery	Soil Vapour (ppm)		Well Name 1 : 03-9
	Sample Interval	Auger Flyte	Vac. Extraction	Water Level 1						Water Level 2	LPH Level 1	
0	GRAVEL (BALLAST) SAND (FILL), well graded, some gravel, well graded, dark brown, loose, damp.											
1	SAND, well graded, trace fine gravel, brown, loose, damp. SAND, well graded, brown, medium dense, wet.											
2	SAND, well graded, trace gravel, well graded, brown grey, medium dense, wet.											
6	End of borehole at 6.1 m.											
7												
8												
9												
10												

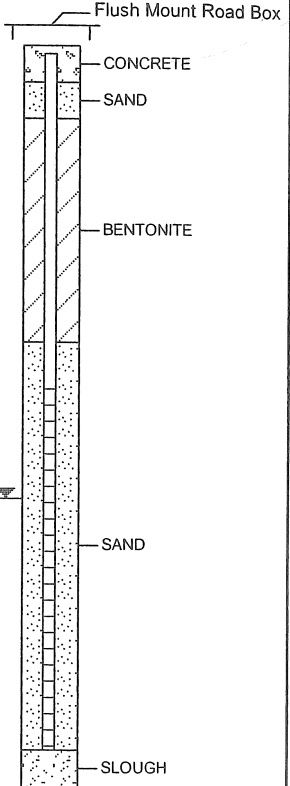

Notes:
Bolded sample denotes sample analyzed.