



SNC-LAVALIN
Environment

Client :
B.C. Hydro and Power Authority

Borehole No. : 12-301

Location :
Rock Bay - Stage 2, Victoria, BC

(Page 1 of 2)


Drilling Contractor: Western Grater
Drilling Method : Odex
Borehole Dia. (m) : 0.10
Pipe/Slotted Pipe Dia. (m): 0.05, 0.05

Date Monitored : 2012 05 06
Ground Surf Elev. (m) : 5.13
Top of Casing Elev. (m) : 4.962
Northing: 5364555.75 Easting: 472543.29

Project Number : 506708
Borehole Logged By : JAR
Date Drilled : 2012 01 24
Log Typed By : MAL

Depth in Metres	Drilling Legend	Water/NAPL Levels	Stratigraphy Plot	Sample Interval Cone Run	Sample Number	Blow Count	% Recovery	Soil Vapour (ppm)	Well Name: 12-301
	<ul style="list-style-type: none"> Sample Interval Odex 	<ul style="list-style-type: none"> Water Level 1 Water Level 2 NAPL NAPL 							
Soil Description									
0	GRAVEL (FILL), trace sand, loose, wet.								
3	BEDROCK, some quartz, angular, black/grey with black mottling and iron staining, weathered.				301-01				
5	Below 4.9 m - purple with dark staining. Below 5.0 m - quartz/calcite.				301-02				
7					301-03				
8					301-04				
10									
...Continued									
<p>Notes: Bolted sample denotes sample analyzed.</p>									

Print Date: 2013 01 08, Date Approved: 2012 04 18

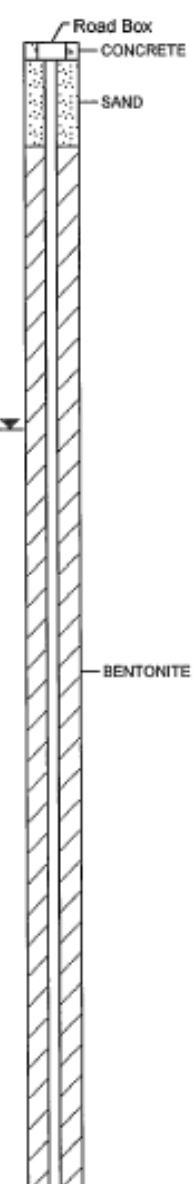



SNC-LAVALIN
Environment

Client :
B.C. Hydro and Power Authority

Borehole No. : 12-301

Location :
Rock Bay - Stage 2, Victoria, BC

(Page 2 of 2)

Drilling Contractor: Western Grater
Drilling Method : Odex
Borehole Dia. (m) : 0.10
Pipe/Slotted Pipe Dia. (m): 0.05, 0.05

Date Monitored : 2012 05 06
Ground Surf Elev. (m) : 5.13
Top of Casing Elev. (m) : 4.982
Northing: 5364555.75 Easting: 472543.29

Project Number : 506706
Borehole Logged By : JAR
Date Drilled : 2012 01 24
Log Typed By : MAL

