



**SNC-LAVALIN**  
Environment

Client :  
H R Tostenson

**Borehole No. : 09-31**

Location :



1155-1157 Ellis St, Kelowna, BC

(Page 1 of 1)

Drilling Contractor: Drain Tech/Beck Drilling  
Drilling Method : Hydrovac/Hollow Stem Auger  
Borehole Dia. (m) : 0.20  
Pipe/Slotted Pipe Dia. (m): 0.05, 0.05

Date Monitored : 2009 08 10  
Ground Surf Elev. (m) : 98.692  
Top of Casing Elev. (m) : 98.617

Project Number : 133178  
Borehole Logged By : KRS  
Date Drilled : 2009 08 06  
Log Typed By : SW

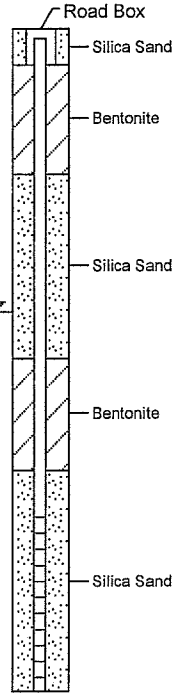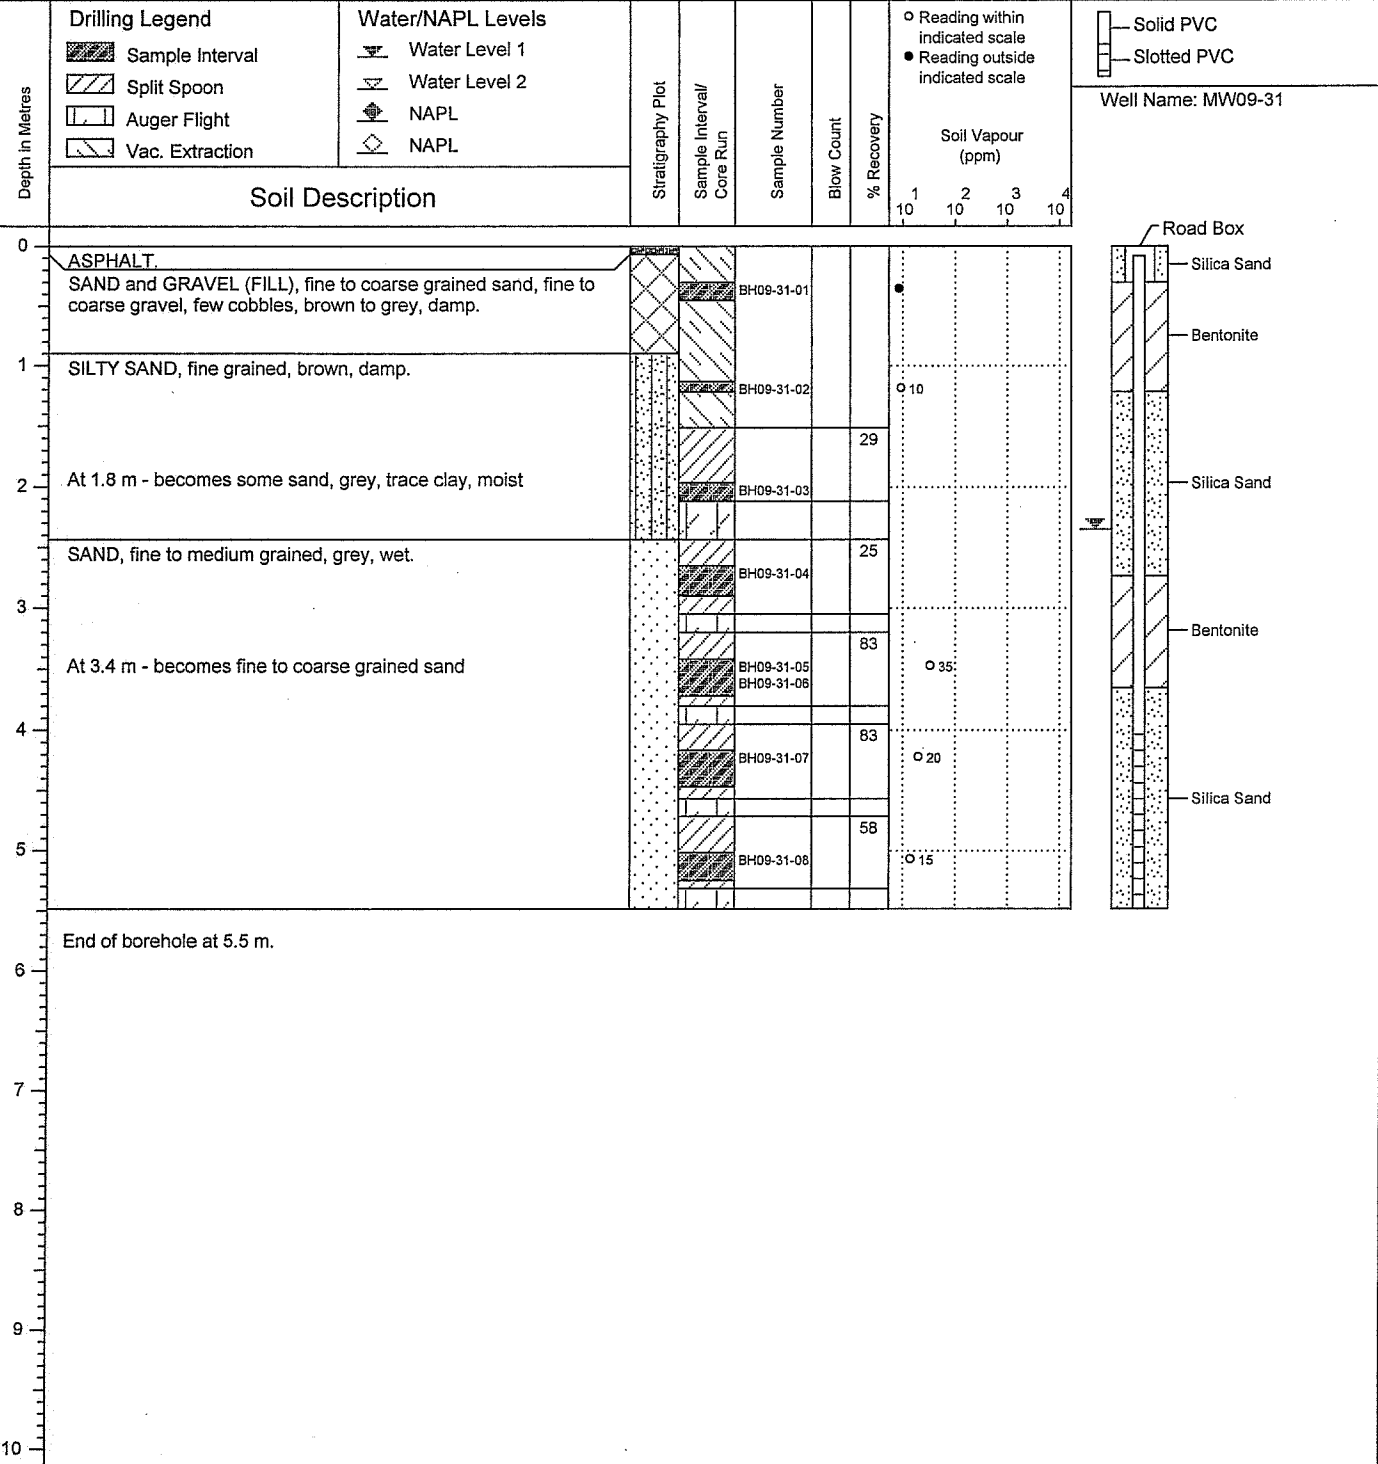

**Notes:**  
 Bolded sample denotes sample analyzed.  
 BH09-31-06 is a blind field duplicate of BH09-31-05.  
 Samples BH09-31-3 to BH09-31-8 collected by split spoon.