



Client
Imperial Oil

Borehole No. : 14-45D


Location
11 Terminal Avenue, Nanaimo, BC

PAGE 1 OF 1

Drilling Contractor Drillwell Enterprises Ltd.
Drilling Method Solid Stem Auger
Borehole Dia. (m) 0.20
Pipe/Slotted Pipe Dia. (m) 0.05/0.05

Date Monitored 2014 07 22
Ground Surface Elev. (m) 9.053
Top of Casing Elev. (m) 9.385
Northing: 5448653.796 Easting: 431537.448

Project Number: 132131
Borehole Logged By: CMT
Date Drilled: 2014 07 15
Log Typed By: NDS

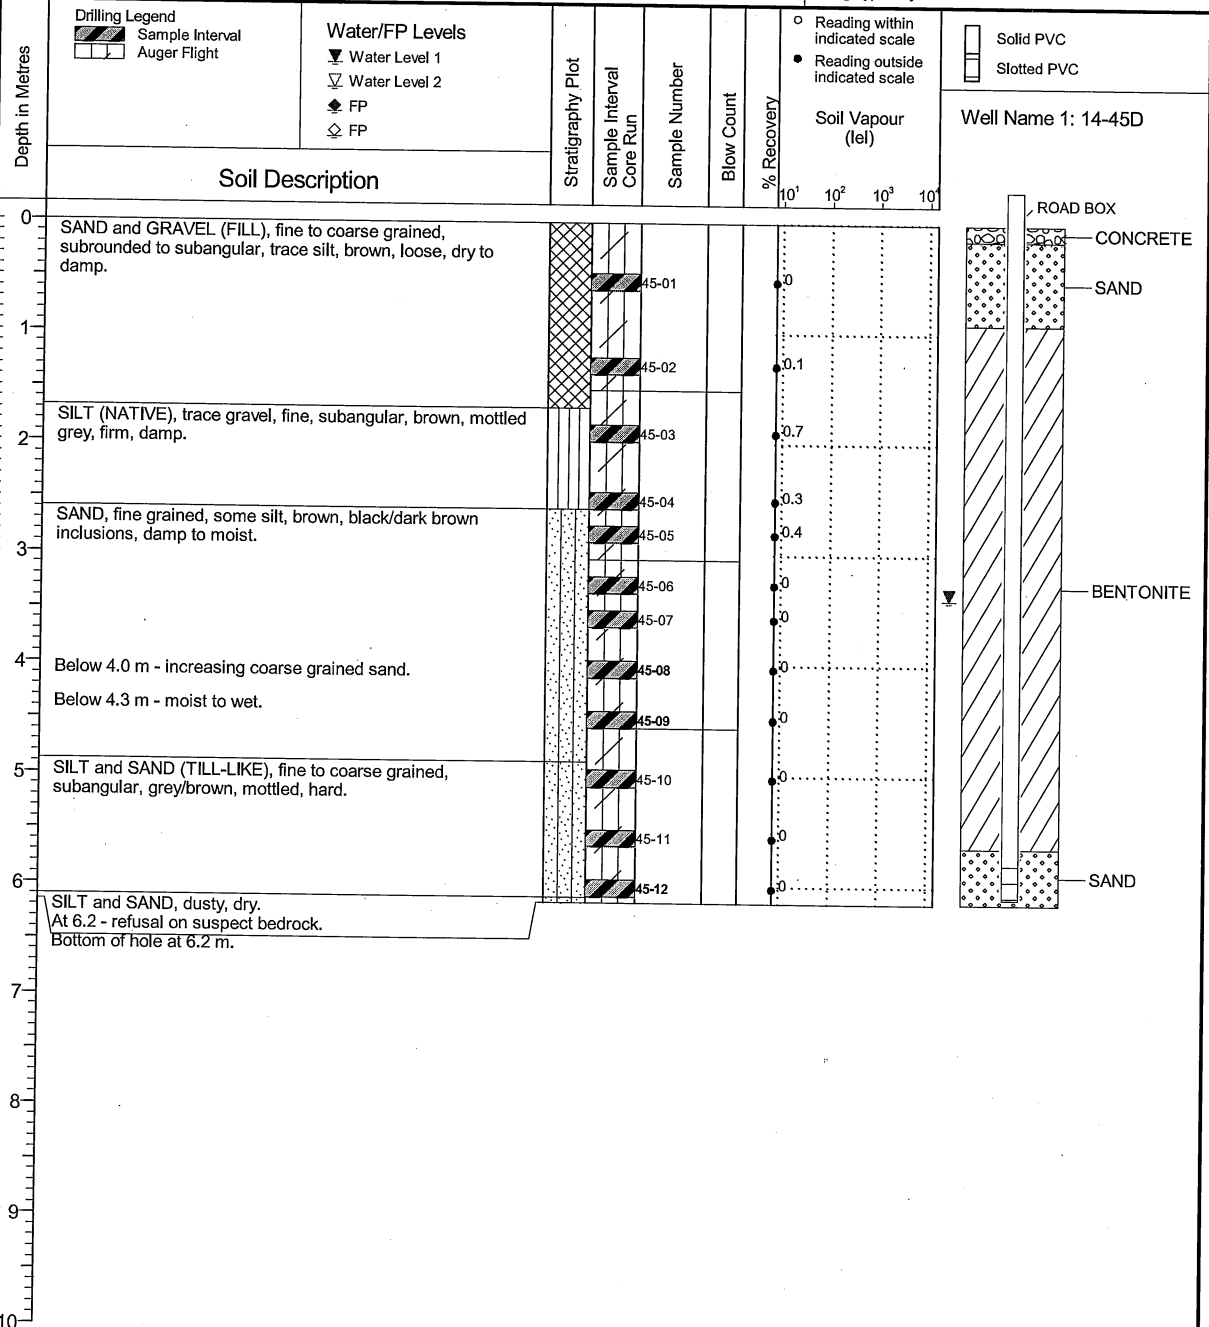

Print Date: 2015.11.19 QA1: CMT Date Approved: 2014.08.13

NOTES
 Bolded sample denotes sample analyzed.
 Well installed with hollow stem auger.

Any use which a person makes of this data, or any reliance on or decisions to be made based on it, are the sole responsibility of such person. Imperial Oil/SNC-Lavalin Inc./CSAP/MOE are not responsible for any use or modification of this data. Imperial Oil/SNC-Lavalin Inc./CSAP/MOE accept no responsibility for losses or damages, if any, suffered by any person as a result of decisions made or actions taken based on this data