


CLIENT: SHELL CANADA PRODUCTS LTD.	DRILLING CONTRACTOR: MUD BAY DRILLING	PROJECT No.: R13-115
LOCATION: 40th AVENUE & 200th STREET, LANGLEY, B.C.	DRILLING METHOD: HOLLOW STEM	DIAMETER: 200 mm
BOREHOLE LOG	PLOTTED: 19961213.1117 CAD FILE No.: 31159621	BOREHOLE No.: 96-21
SAMPLE TYPE: <input type="checkbox"/> CORE <input checked="" type="checkbox"/> SPLIT SPOON <input type="checkbox"/> SHELBY <input checked="" type="checkbox"/> DISTURBED <input type="checkbox"/> NO RECOVERY		

DEPTH (m)	SOIL DESCRIPTION	STRATIGRAPHY PLOT	SAMPLE TYPE	SAMPLE NUMBER	SOIL VAPOUR CONCENTRATION (ppm)			WATER LEVEL	MONITORING WELL INSTALLATION
					100	1000	10000		
0									
1									
2	SAND, medium grained, some gravel, well rounded, olive grey, loose, moist. -at 4.6 m, faint to moderate hydrocarbon odour -at 6.1 m, oxidized staining at 6.1 m, strong hydrocarbon odour, oily coating on gravel End of borehole at 9.6 m.								
3				96-21-1					
4				96-21-2					
5				96-21-3					
6				96-21-4					
7									
8									
9				96-21-5					

- LEGEND**
- road box
 - 50 mm PVC pipe
 - 50 mm slotted PVC pipe
 - bentonite seal
 - silica sand backfill
 - concrete seal
 - slough

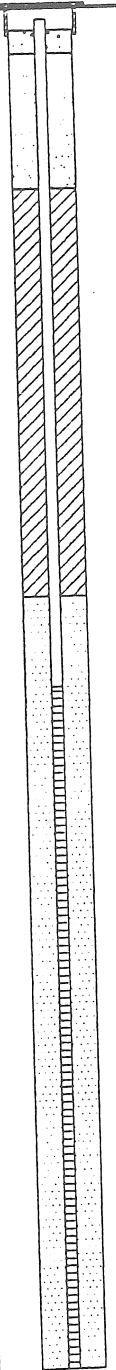

GROUND SURFACE ELEVATION (m):
45.419

TOP OF CASING ELEVATION (m):
45.317

DATE DRILLED: 1996-11-22

OBSERVED WATER LEVEL:
LOGGED BY:
E.V.W. SHEET 1 OF 1