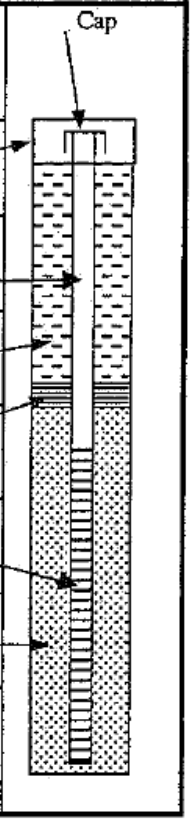Borehole ID#		MW5				7-May-01	
Depth of strata change (m)		Observations	Sample Depth.	Vapour PPM.	Vapour %LEL.	Stand pipe notes	
0	0.3	Beige sand gravel (fill)				Steel Casing	
0.3	0.9	Grey gravelly fine sand with wood chips (fill)	0.6	450	3	50mm Solid PVC Pipe (0-1.5m)	
0.9	1.5	Grey gravelly fine sand (possible fill)	1.05	290	2	Cuttings	
1.5	2.4	Grey silt fine sand	1.8	140		Bentonite Chips (1.0-1.3m)	
2.4	3	Grey clay with black organic horizons	2.4	100		50mm Slotted PVC pipe (1.5-3.0m)	
						Filter Sand	
		Depth to water: 2.152 Elevation of MW rim: 99.563 Elevation of Water Table: 97.411					
						End of hole