


CLIENT: British Columbia Packers	CONTRACTOR: Uniwide	BOREHOLE NO: 97-04
PROJ: Soil and Groundwater Investigation	METHOD: Solid Stem Auger	PROJECT NO: VE40116
BC Packers, Steveston	PROJECT ENGINEER: AHE	ELEVATION:

SAMPLE TYPE AUGER FLYTES BAG SAMPLE SPLIT SPOON

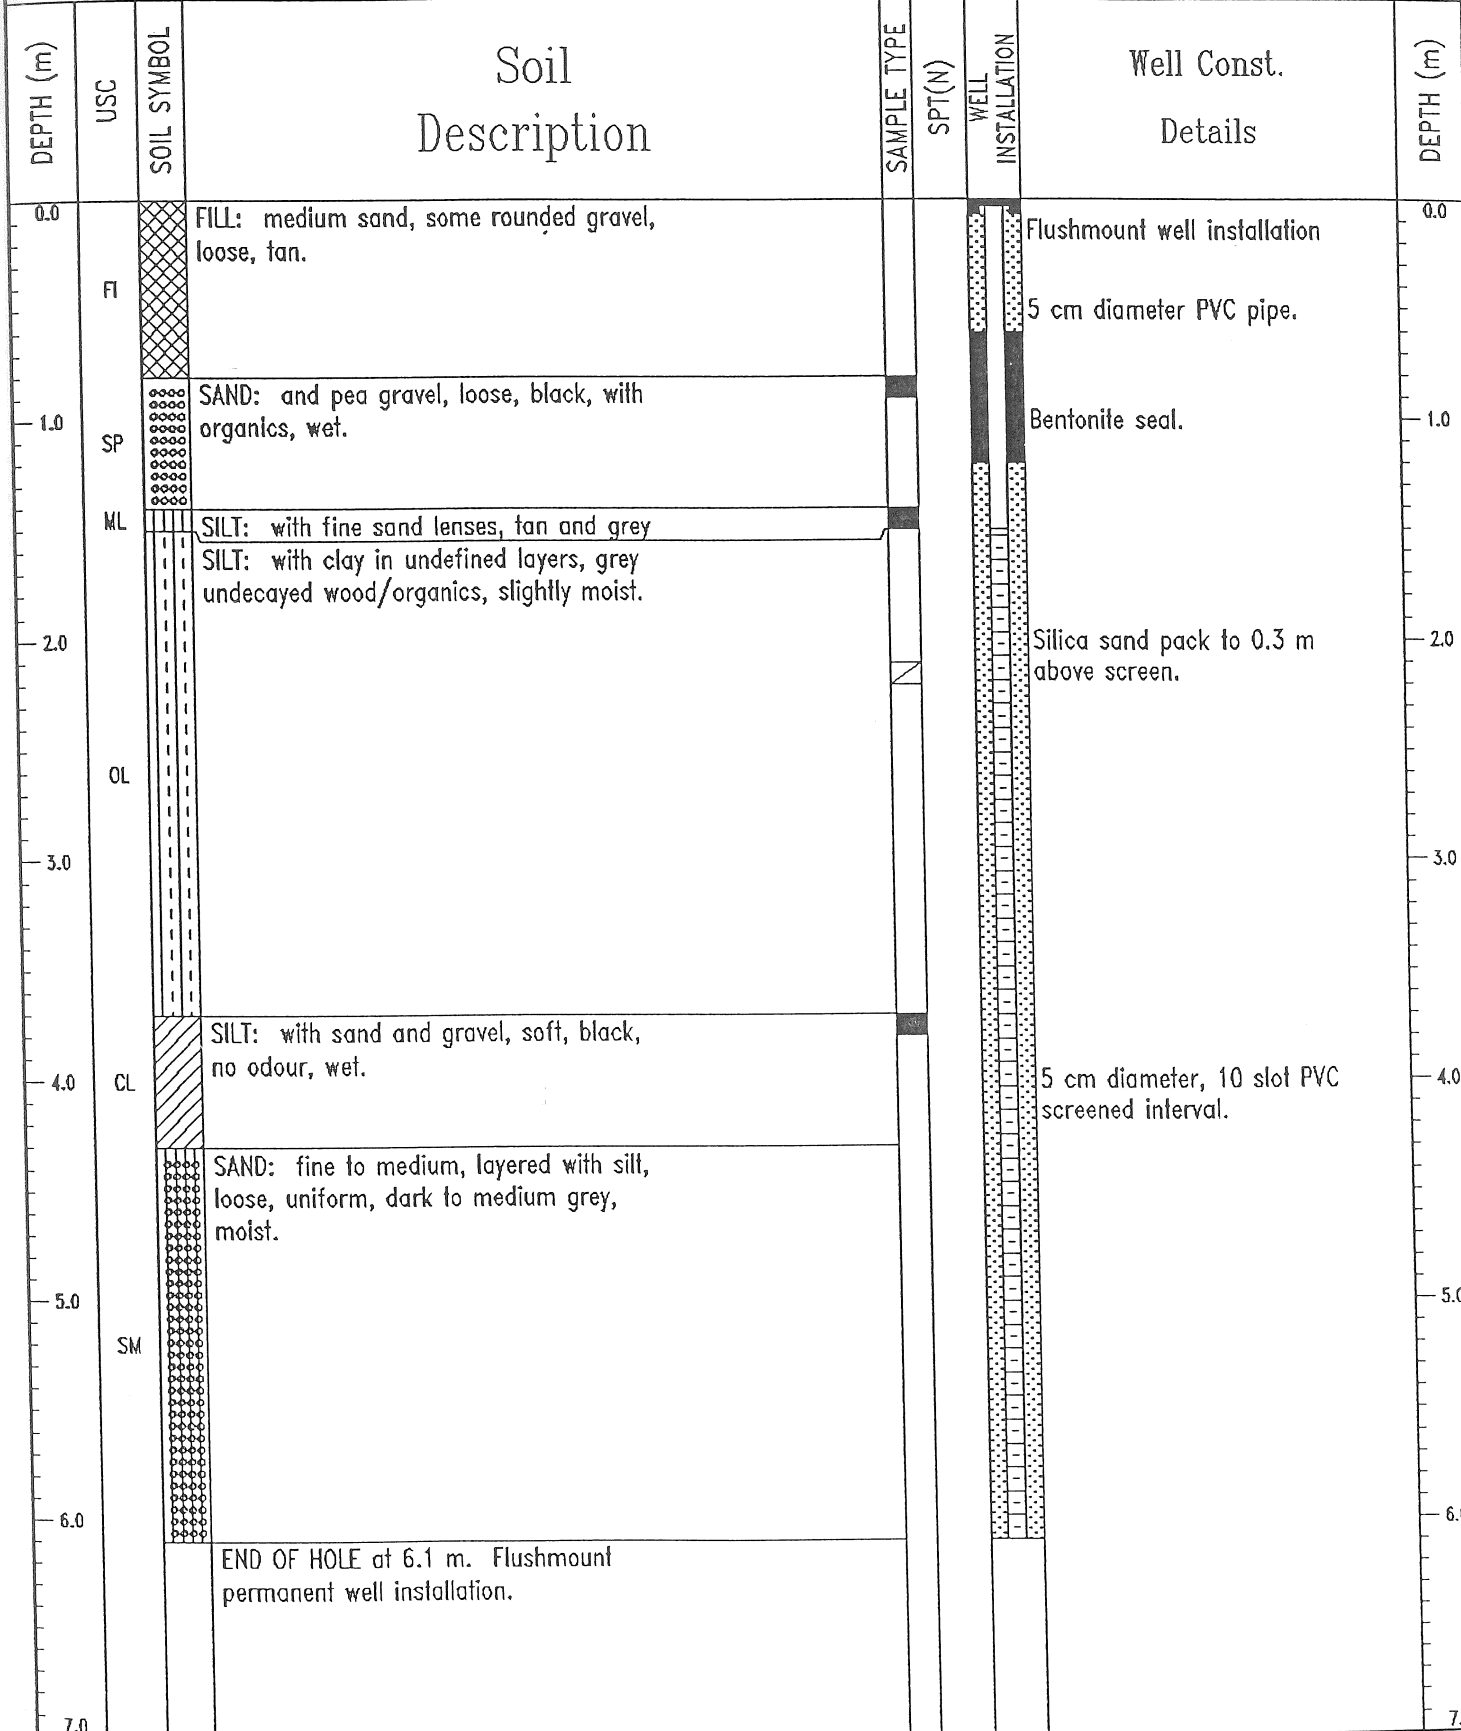

AGRA Earth & Environmental Limited Burnaby, B.C.	LOGGED BY: AHE	COMPLETION DEPTH: 6.1 m
	REVIEWED BY: JTL	COMPLETE: 19/03/97
	Fig. No: 97-04	Page 1 of 1