


British Columbia Packers Ltd.	Uniwide Drilling Ltd.	BOREHOLE NO: 98-28
Detailed Site Investigation	Track-Mounted Auger Drill Rig	PROJECT NO: VE50945-2000
BC Packers - Steveston Site	Solid Stem Auger	ELEVATION:
SAMPLE TYPE <input checked="" type="checkbox"/> DISTURBED <input checked="" type="checkbox"/> NO RETURN <input checked="" type="checkbox"/> SPLIT SPOON <input type="checkbox"/> AUGER FLYTES <input type="checkbox"/> CORE BARREL RUN <input type="checkbox"/> CORE SAMPLES		

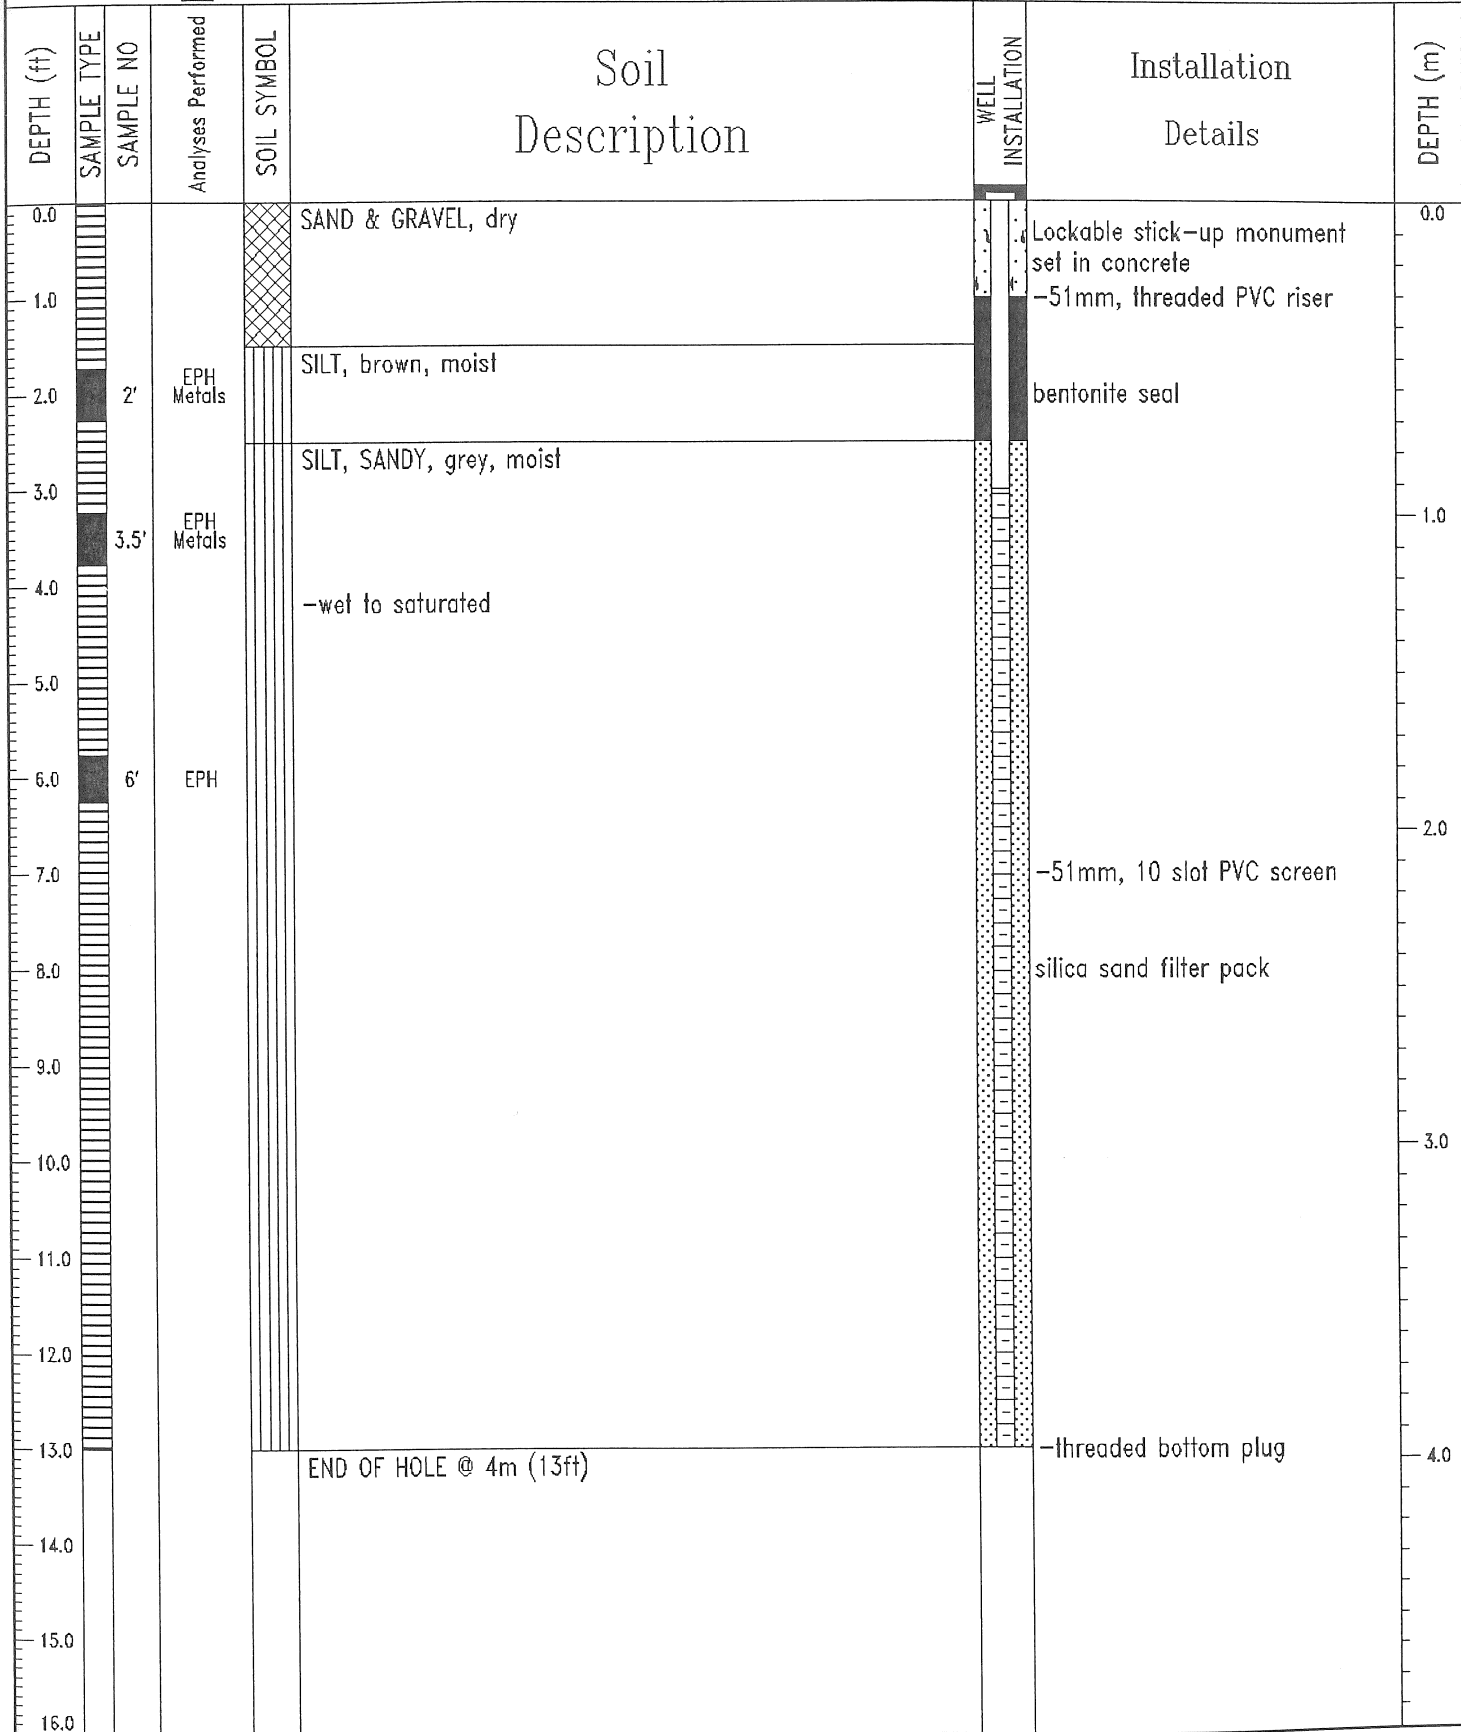

AGRA Earth & Environmental Limited Burnaby, B.C.	LOGGED BY: GRE	COMPLETION DEPTH: 13.0 ft
	REVIEWED BY: JTL	COMPLETE: 30/10/98
	Fig. No: 98-28	Page 1 of 1