

# WELL RECORD

WELL NO:







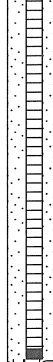

CLIENT: Raegon Properties and Investments Ltd.

PGL PROJECT NO: 3793-02.01

## BH22M

PROJECT: Duck Island

SURFACE ELEVATION: n/a

DEPTH (m)	SOIL TYPE	SOIL DESCRIPTION	SAMPLE TYPE	LABORATORY ANALYSES	VAPOUR READING (ppmv)	GROUNDWATER OBSERVATIONS	WATER LEVEL	WELL COMPLETION	COMPLETION NOTES	ELEVATION (m)							
0.2		<b>SAND AND GRAVEL</b> medium grained, very dense, grey, dry		BH22M/0.5	15 ▲				Roadbox, J-plug								
0.4																	
0.6																	
1.0		<b>Sandy SILT</b> some gravel, trace clay, grey, moist		BH22M/1.8: Metals	35 ▲				Bentonite								
1.2																	
1.4																	
1.6																	
1.8																	
2.0																	
2.2																	
2.4																	
2.6																	
2.8																	
3.0																	
3.2																	
3.4																	
3.6																	
3.8																	
4.0																	
4.2																	
4.4																	
4.6																	
									50mm 010 Slotted PVC								
									Slough								

GW 1.69 m  
(2/15/2011)  
0.41 m  
product  
thickness  
detected on  
groundwater  
surface

 

End of borehole at 4.60 m.

Screened interval from 1.2 m to 4.3 m below surface.

Vacuum excavated from 0 m to 1.5 m below surface.

PGL BOREHOLE LOG-DECEMBER 2010\_3793-02.01 BOREHOLE LOGS.GPJ PGL CANADA.GDT: 3/30/11

INVESTIG. METHOD: Solid Stem / Hollow Stem Auger  
INVESTIG. DATE: February 11, 2011  
LOGGED BY: ASN/RRM

Sample Notes  Grab Sample  Auger