


CLIENT: IMPERIAL OIL	DRILLING CONTRACTOR: SONIC DRILLING	PROJECT No.: V8-224E
LOCATION: 801 WEST 1st STREET, NORTH VANCOUVER, BC	DRILLING METHOD: VIBRATORY	DIAMETER: 170 mm
BOREHOLE LOG		BOREHOLE No.: BH209
PLOTTED: 19990406.1537 CAD FILE No.: 8224W209 SG/AJK		SAMPLE TYPE: <input type="checkbox"/> CORE <input checked="" type="checkbox"/> SPLIT SPOON <input type="checkbox"/> SHELBY <input checked="" type="checkbox"/> DISTURBED <input type="checkbox"/> NO RECOVERY

DEPTH (m)	SOIL DESCRIPTION	STRATIGRAPHY PLOT SAMPLE TYPE	SAMPLE NUMBER	SOIL VAPOUR CONCENTRATION (ppm)			WATER LEVEL	MONITORING WELL INSTALLATION
				10	100	1000		
0	<b>SAND and GRAVEL (FILL)</b> , light brown.							
	<b>SAND and GRAVEL (FILL)</b> , some silt, dark grey, damp.							
1	<b>SAND</b> , fine grained, some silt to silty, some gravel, light grey, stiff, moist. - between 1.2 m and 1.5 m, brown - between 1.5 m and 1.8 m, mottled grey-brown - between 1.8 m and 2.1 m, grey - at 2.0 m, 50 mm organic layer (wood, roots, rootlets, etc.)							
2	<b>SAND</b> , fine to medium grained, some silt, trace organics, dark brown, moist. <b>SILT</b> , some fine grained sand, light brown, soft. - from 2.7 m, slightly sandier, wet							
3	<b>SAND</b> , medium to coarse grained, trace gravel, dark brown, loose.							
4	<b>SAND and GRAVEL</b> , coarse grained sand, sub-rounded gravel, some cobbles, loose, wet. - between 3.3 m and 4.0 m, brown - below 4.0 m, greyish-brown							
5	No recovery	o						
6	<b>SAND and GRAVEL</b> , coarse grained sand, sub-rounded gravel, some cobbles, greyish brown, loose, wet.							
7								
8	<b>SAND</b> , fine grained, silty, dark grey, soft, moist. End of borehole at 8.2 m.							
9								

- LEGEND**
- road box
  - 50 mm  $\phi$  PVC pipe
  - 50 mm  $\phi$  slotted PVC pipe
  - bentonite seal
  - silica sand backfill
  - concrete seal
  - slough
  - cuttings
  - bentonite grout

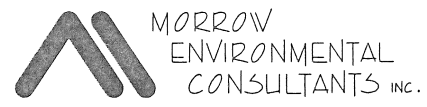

GROUND SURFACE ELEVATION (m): 4.208	DATE DRILLED: 1998 12 11
TOP OF CASING ELEVATION (m): 4.128	OBSERVED WATER LEVEL:
	LOGGED BY: CMS
	SHEET 1 OF 1