



Client
Ministry of Transportation and Infrastructure

Location
9568 Burns Drive, Delta, BC


Borehole No. : 14-32D

PAGE 1 OF 1

Drilling Contractor: Uniwide Drilling Co. Ltd/McRae..
 Drilling Method: Hydrovac/Solid Stem Auger
 Borehole Dia. (m): 0.25
 Pipe/Slotted Pipe Dia. (m): 0.05/0.05

Date Monitored: 2014 01 30
 Ground Surface Elev. (m): 1.722
 Top of Casing Elev. (m): 1.641
 Northing: 5437665.594
 Easting: 503037.418

Project Number: 511068
 Borehole Logged By: CMH
 Date Drilled: 2014 01 21
 Log Typed By: SGP

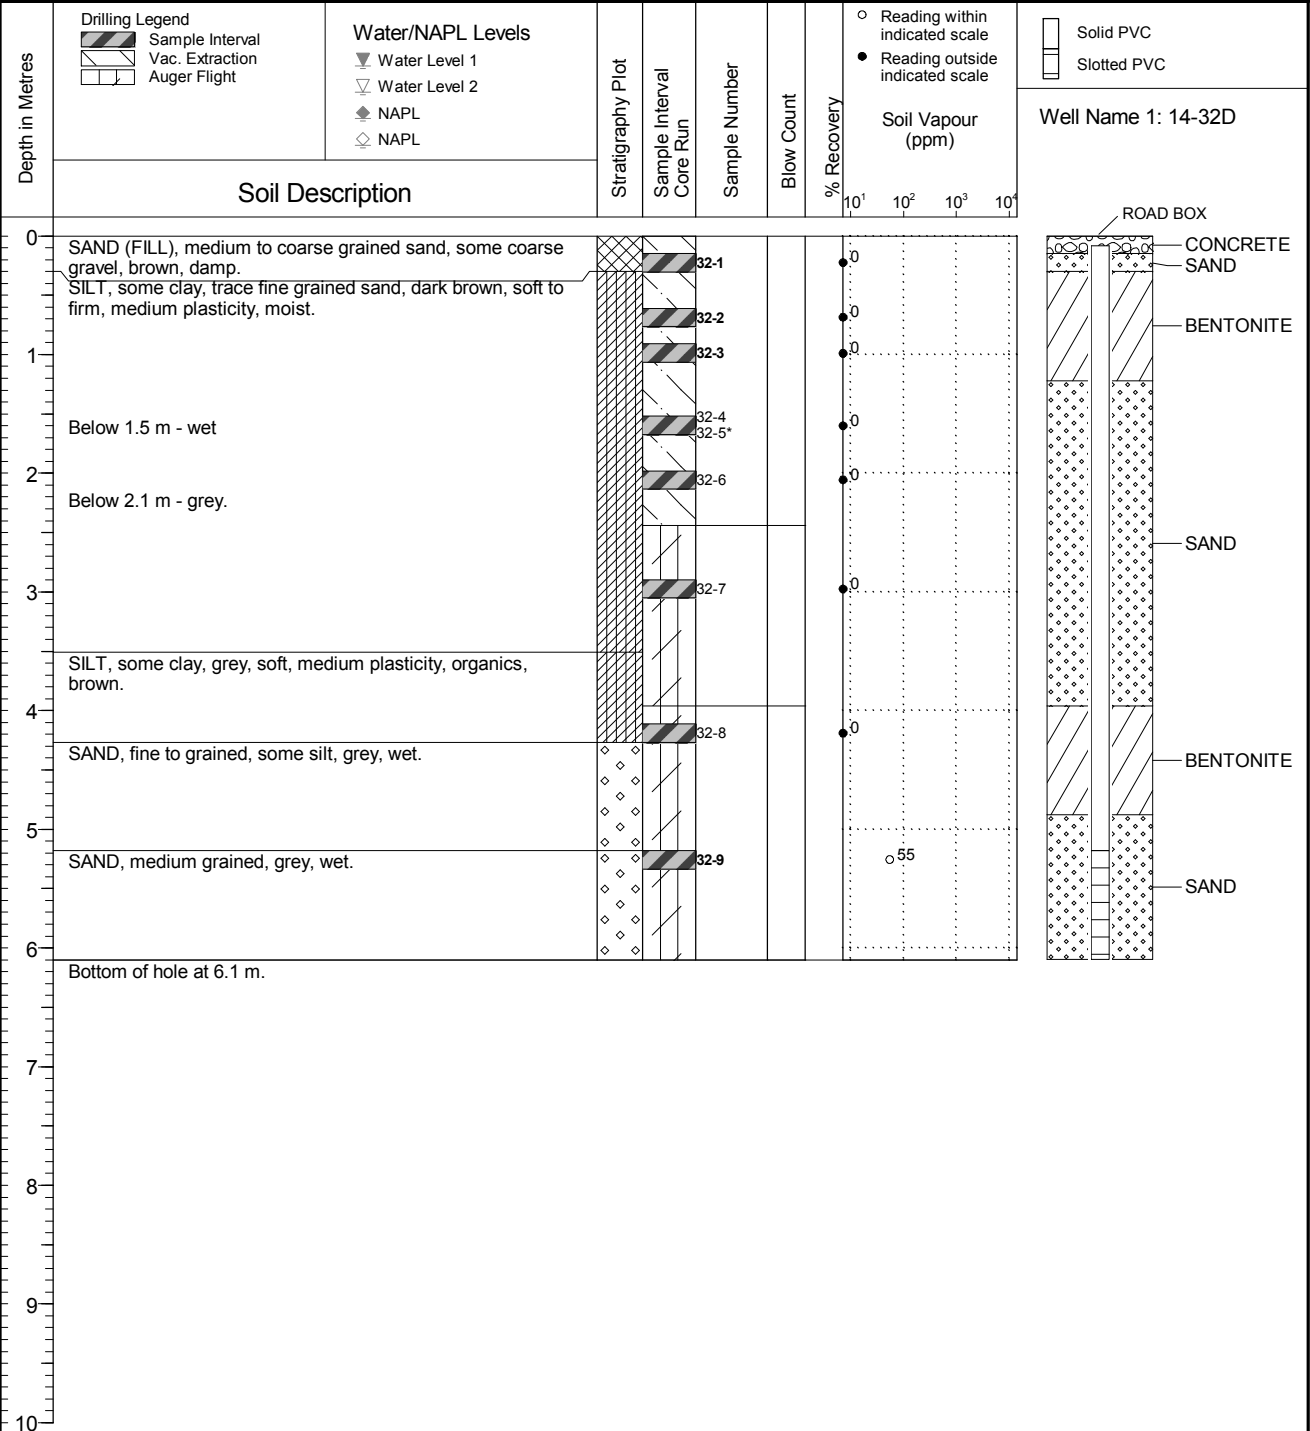

NOTES
 Bolded sample denotes sample analyzed.
 * 32-5 denotes blind field duplicate of 32-4.