


PROJECT: DETAILED SITE INVESTIGATION	CLIENT: CITY OF NANAIMO	BOREHOLE NO: BH05-42
LOCATION: FOUNDRY	CONTRACTOR: BECK DRILLING	PROJECT NO: 0802-2840298
	METHOD: SOLID STEM AUGER	ELEVATION:

SAMPLE TYPE	<input checked="" type="checkbox"/> DISTURBED	<input checked="" type="checkbox"/> NO RECOVERY	<input checked="" type="checkbox"/> SPT	<input type="checkbox"/> A-CASING	<input type="checkbox"/> SHELBY TUBE	<input type="checkbox"/> CORE
BACKFILL TYPE	<input checked="" type="checkbox"/> BENTONITE	<input type="checkbox"/> PEA GRAVEL	<input type="checkbox"/> SLOUGH	<input type="checkbox"/> GROUT	<input type="checkbox"/> DRILL CUTTINGS	<input type="checkbox"/> SAND

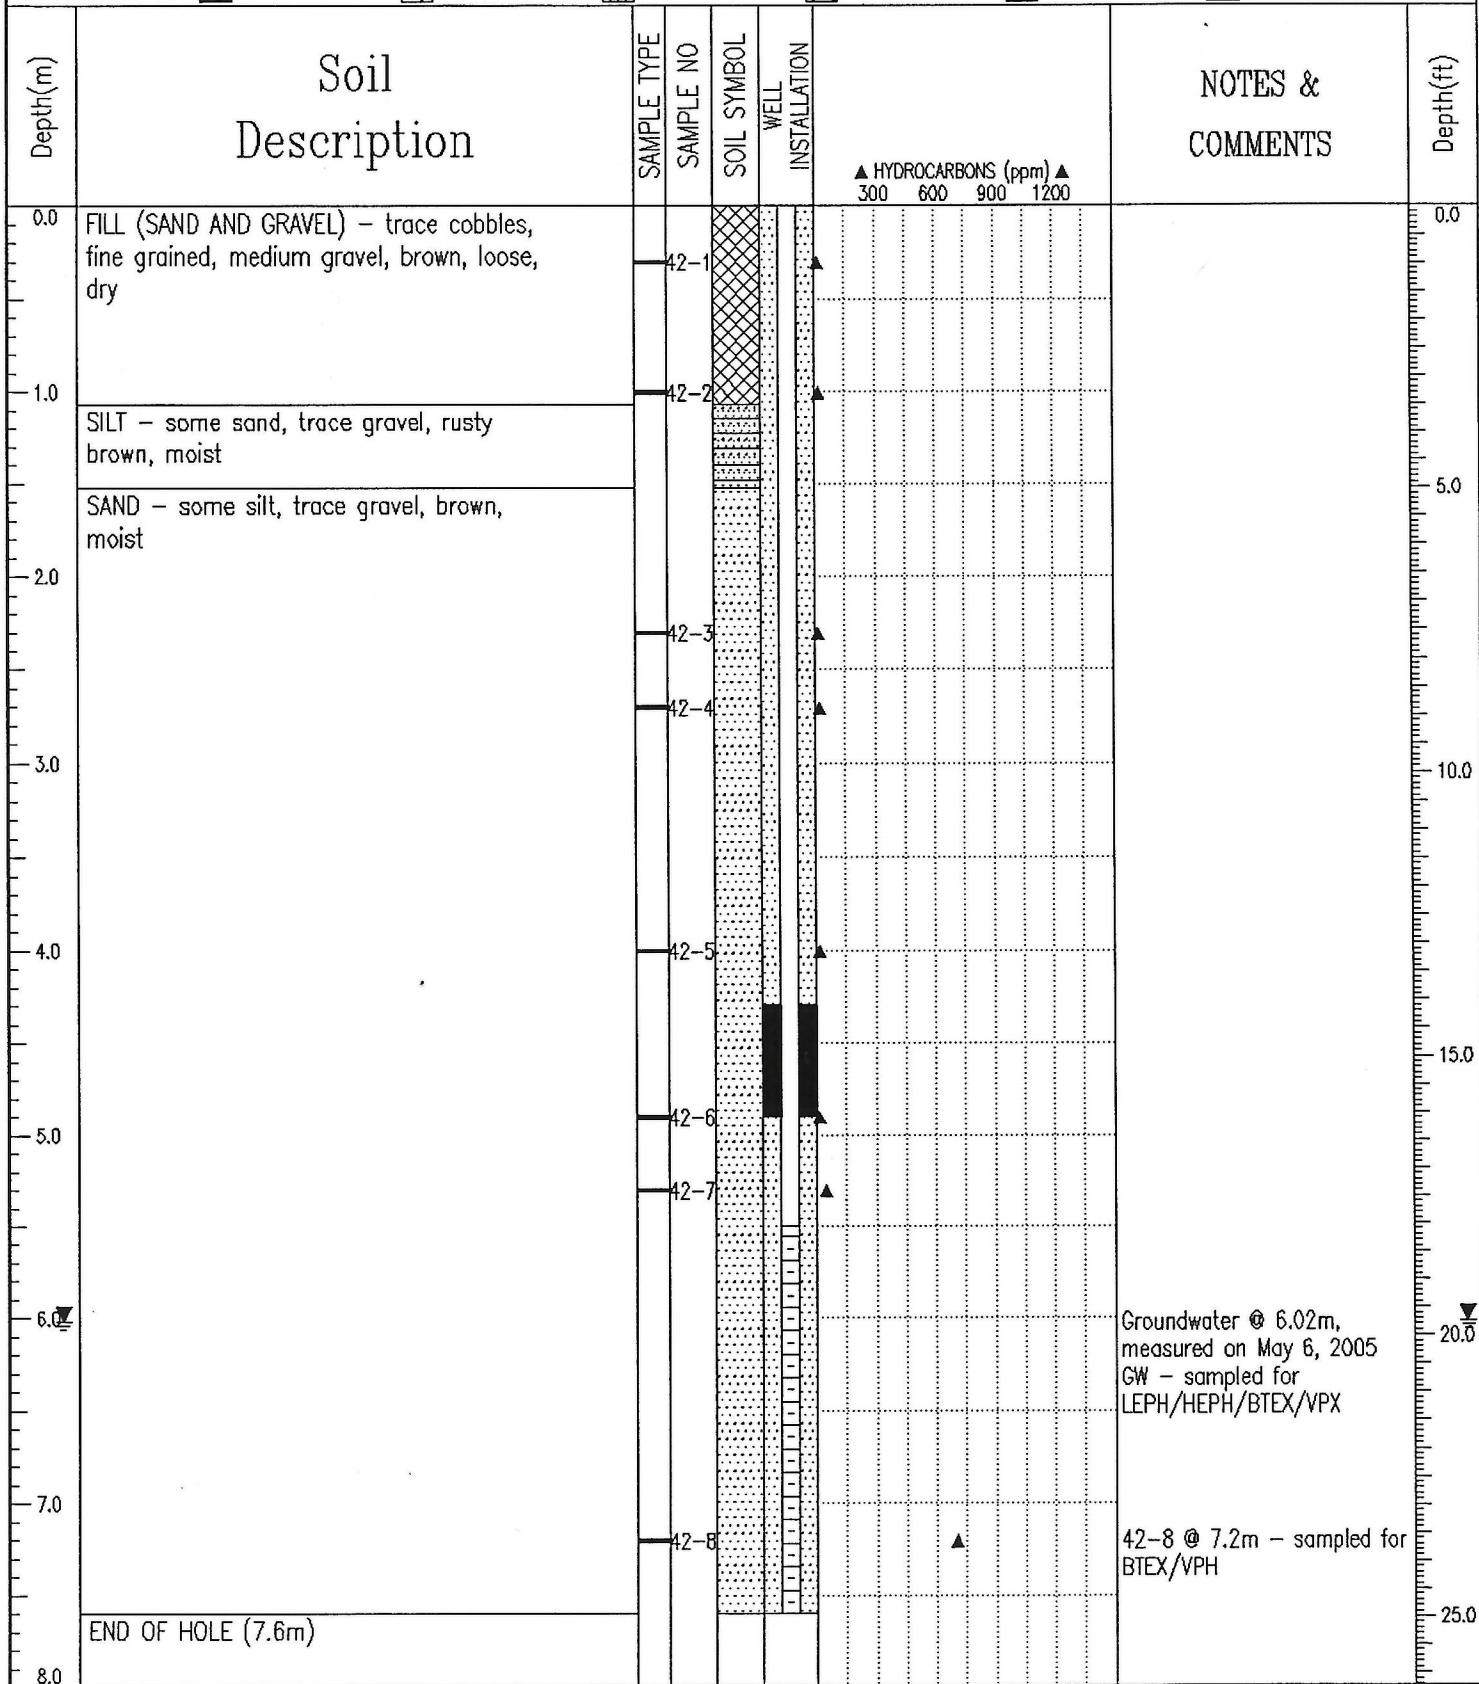

EBA Engineering Consultants Ltd.	LOGGED BY: CP	COMPLETION DEPTH: 7.6 m
	REVIEWED BY: KT	COMPLETE: 28/04/05