



SNC-LAVALIN
Morrow Environmental

Client :
Imperial Oil Limited

Borehole No. : 02-8


Location :
City of Surrey Property

(Page 1 of 1)

Drilling Contractor: Uniwide Drilling Co. Ltd.
Drilling Method : Hollow Stem Auger/Day-Lighting
Borehole Dia. (m) : 0.15
Pipe/Slotted Pipe Dia. (m): 0.05, 0.05

Date Monitored : 2002 12 23
Ground Surf Elev. (m) : 36.32
Top of Casing Elev. (m) : 36.227

Project Number : 130897
Borehole Logged By : DLC
Date Drilled : 2002 12 19
Log Typed By : SPK

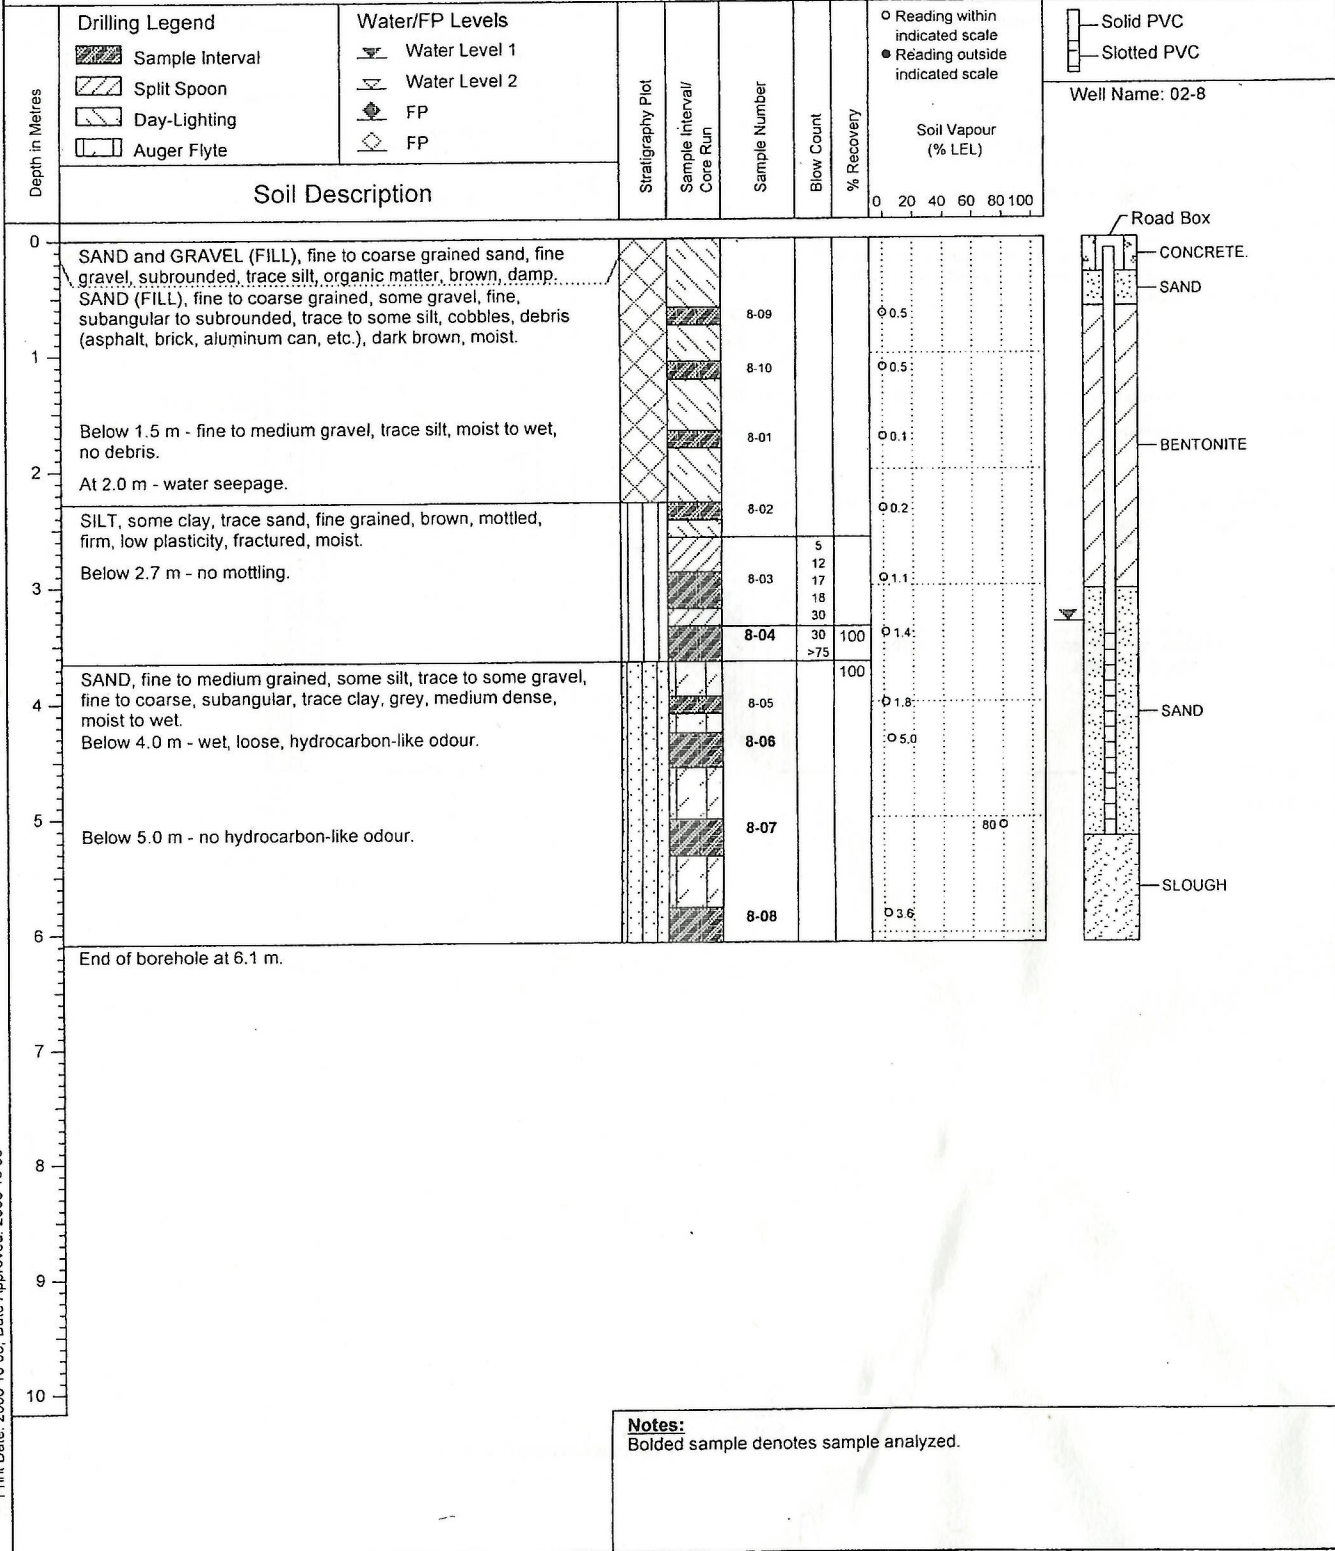

Notes:
Bolded sample denotes sample analyzed.