


Drilling Contractor: Uniwide Drilling Co. Ltd.
Drilling Method : Hollow Stem Auger
Borehole Dia. (m) : 0.20
Pipe/Slotted Pipe Dia. (m): 0.05, 0.05

Date Water Lev. Meas. : 2002 04 02
Ground Surf Elev. (m) : 7 211
Top of Casing Elev. (m) : 8 186

Project Number : R12211
Borehole Logged By : ADR
Date Drilled : 2002 03 26
Log Typed By : MRT

Depth in Metres	Soil Description	Stratigraphy Plot	Sample Interval/ Core Run	Sample Number	Blow Count	% Recovery	Soil Vapour (ppm)				Well Name 1 : MW02-7	
							1	2	3	4		
0	SAND, (FILL), medium grained, some gravel, coarse grained, subangular, trace silt, dark greyish brown, loose, wet, hydrocarbon stain and odour.					100						
1			BH02-7-1 BH02-7-2*					1700	0			
2	SILT, (TILL-LIKE) sandy, fine grained, occasional gravel, fine grained, subangular, dark grey, very stiff, moist to wet.		BH02-7-3			100		480	0			
3	SAND, medium grained, some gravel, well graded, subangular and subrounded, trace silt, dark grey, dense, wet.		BH02-7-4					450	0			
4			BH02-7-5			100		360	0			
5			BH02-7-6		60 78 78 78	100		0	16			
5.64	Split spoon refusal at 5.64m.		BH02-7-7		60 190	100						
6	End of borehole at 5.6 m.											

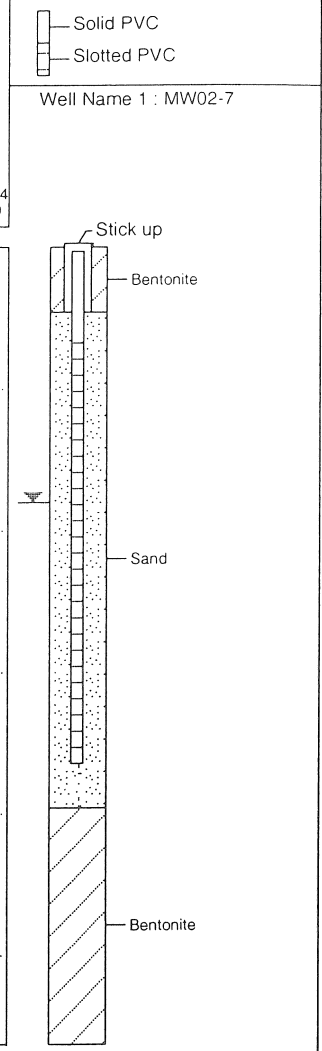

Notes:
 Bolded sample denotes sample analyzed.
 * denotes blind field duplicate.
 Drilling between 4.6 m and 5.65 m completed with hollow stem auger.
 Hollow stem auger employed to complete well installation.