


SEACOR ENVIRONMENTAL INC.

SEACOR JOB NO: 201.10022

CLIENT: **Imperial Oil**
 PROJECT: Hope Water Avenue
 741 Water Avenue
 Hope, BC

BOREHOLE LOG

BOREHOLE NO: **BH02-6**
 ELEVATION: 100.042

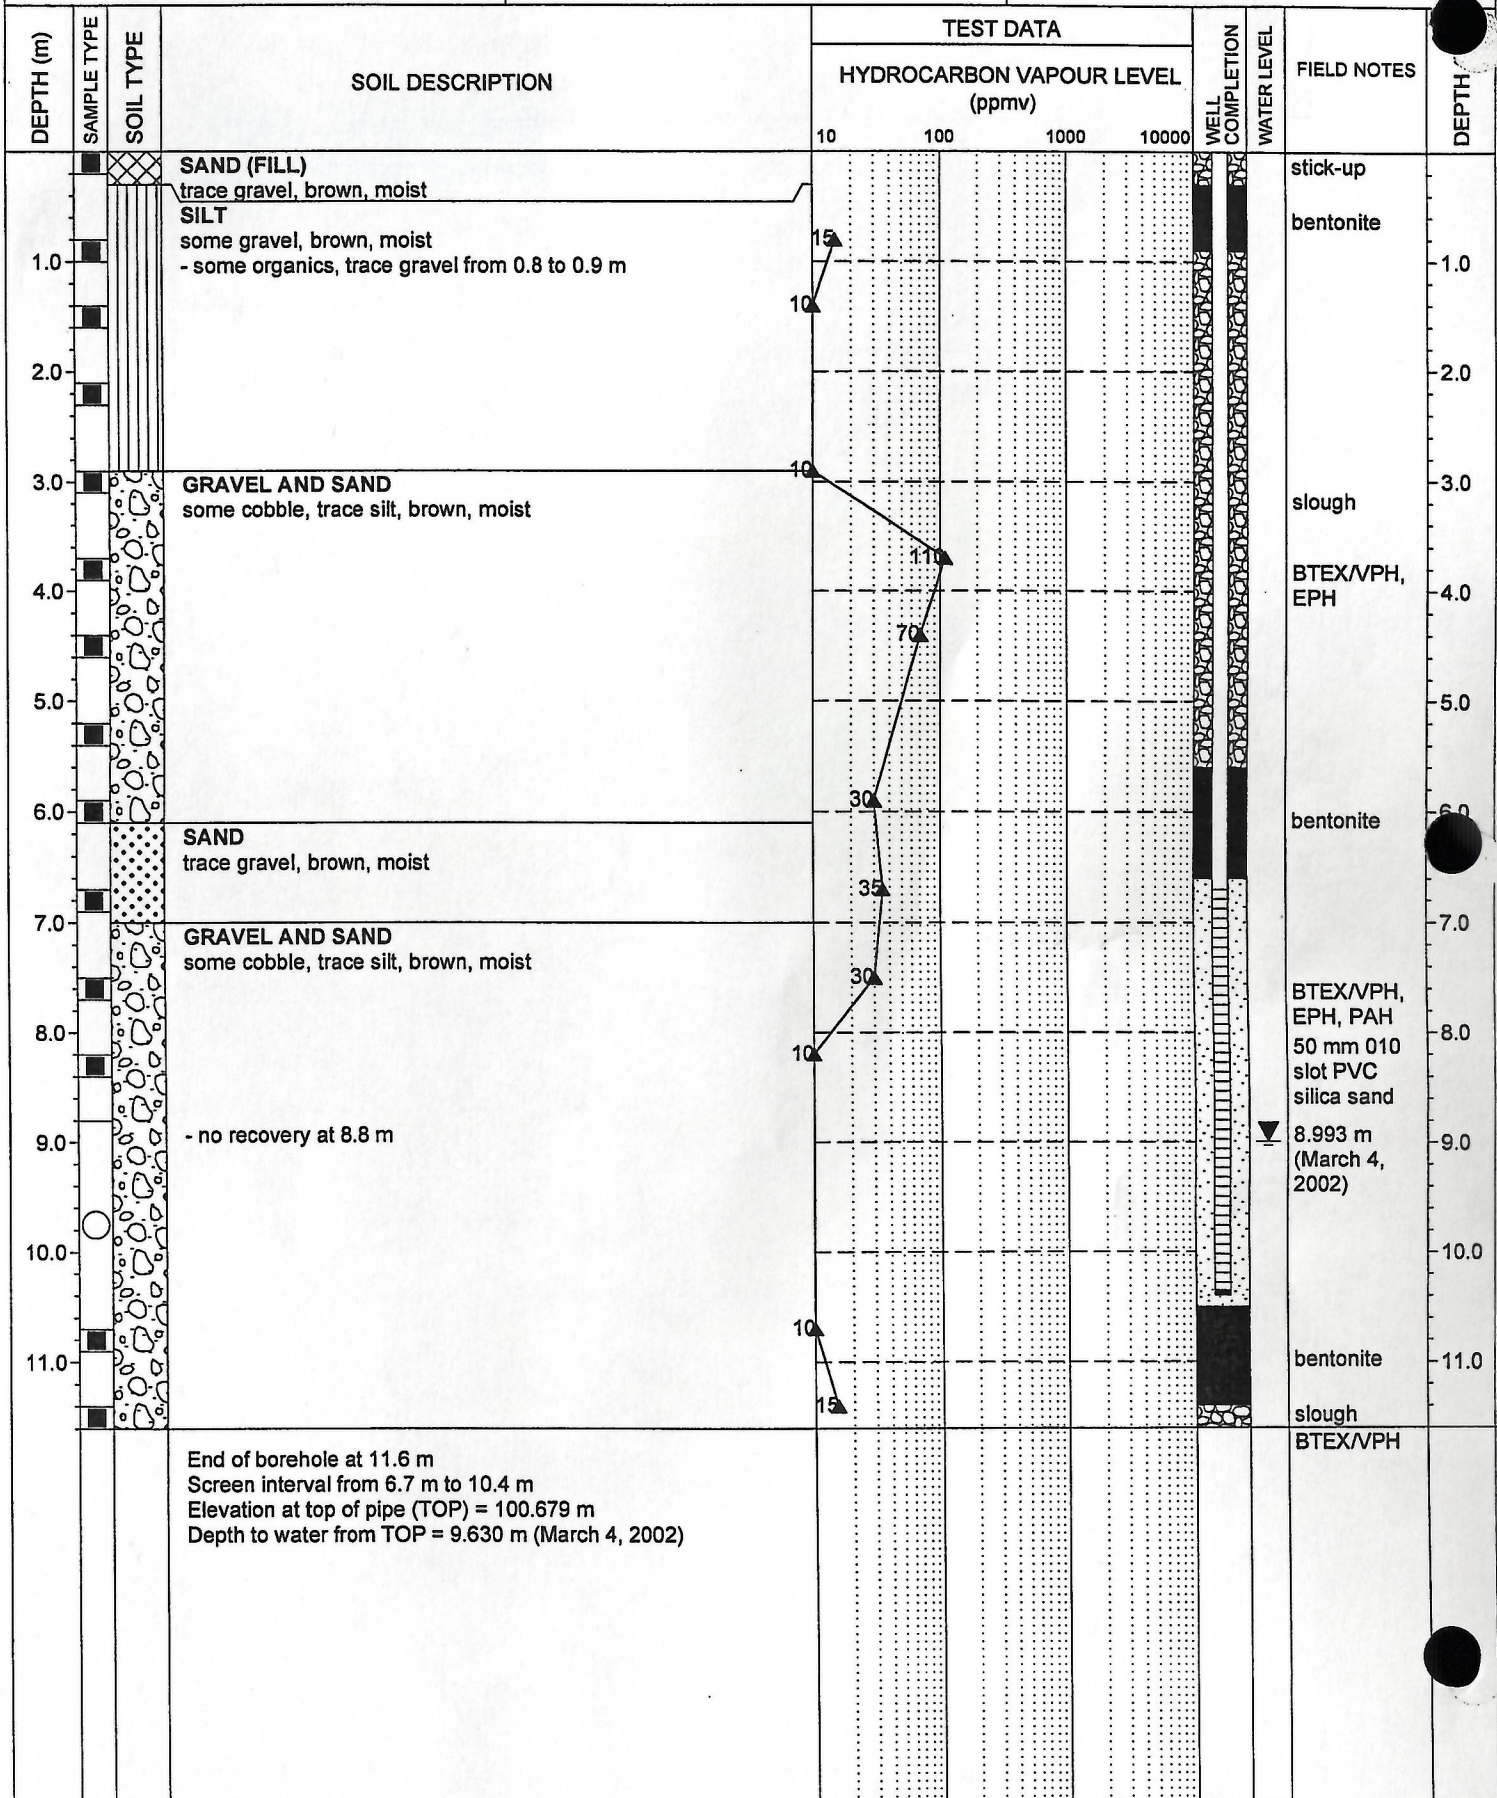

End of borehole at 11.6 m
 Screen interval from 6.7 m to 10.4 m
 Elevation at top of pipe (TOP) = 100.679 m
 Depth to water from TOP = 9.630 m (March 4, 2002)

DRILLING METHOD: Sonic Drilling Ltd.; logged by TM

DATE DRILLED: 2/13/02

Notes: █ Sonic Core Sample
 ○ No Recovery