



Client: SHELL CANADA PRODUCTS

Location: 271 South Shore Road
Lake Cowichan, BC

Borehole No.: 00-5

(Page 1 of 1)


Drilling Contractor : Uniwide Drilling
 Drilling Method : Solid Stem Auger
 Borehole Diam. (mm) : 150
 Ground Surf. Elev. (m) : 170.14 (G)
 (L=local G=geodetic elevation)

Date Water Lev. Meas : 2001 08 13

Project Number : V8-126
 Borehole Logged By : ADR
 Date Drilled : 2000 06 23
 Log Typed By : SJP

Depth in Meters	Sample Type	Water/LPH Levels	Stratigraphy Plot	Sample Type	Sample Number	Blow Count	% Recovery	Soil Vapour (ppm)			
	<input checked="" type="checkbox"/> Grab (disturbed) <input checked="" type="checkbox"/> Split Spoon <input type="checkbox"/> Core <input type="checkbox"/> No Recovery	<input type="checkbox"/> Water Level 1 <input type="checkbox"/> Water Level 2 <input checked="" type="checkbox"/> LPH Level						10 ¹	10 ²	10 ³	10 ⁴
	Soil Description										
0	SAND, (FILL), medium grained, trace coarse grained, gravelly, fine to medium grained, sub-angular and sub-rounded, some cobble, trace silt, very dark brown, medium dense, damp to moist.										
1	SILT and SAND, fine to coarse grained, some gravel to gravelly, sub-angular and sub-rounded, brown, medium dense, moist to wet.										
2	SILT, trace sand, fine grained, trace gravel, sub-angular and sub-rounded, brown to greyish brown, hard, low plastic, damp.										
3	Below 3.4 m - becomes silt, trace to some clay, grey, stiff to very stiff, medium plastic, damp.										
4											
5	Below 5.0 m - becomes moist.										
6											
7											
8											
9	End of borehole at 9.14.										

Well Name: MW00-5
 TOC Elev. (m): 170.076

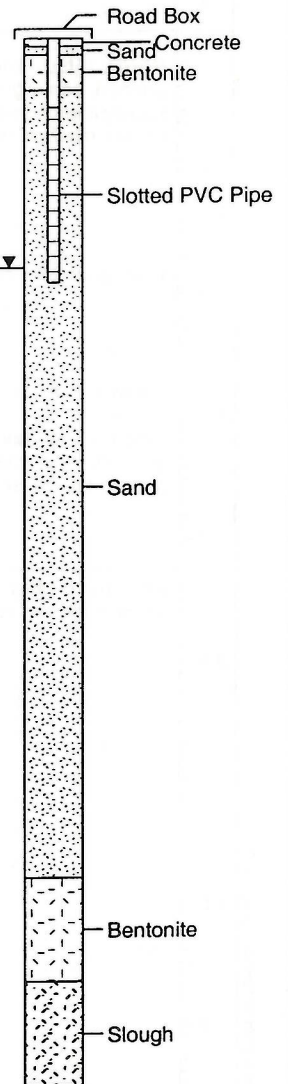

09-18-2002 \ATA_SRV\BOREHOLE\8126\8126W05.BOR

Notes:
 Sample I.D. 00-5-12* is a Blind Field Duplicate of 00-5-11.