


DEPTH (m)	SAMPLE TYPE	SOIL TYPE	SOIL DESCRIPTION	TEST DATA				WELL COMPLETION	WATER LEVEL	FIELD NOTES	DEPTH (m)
				HYDROCARBON VAPOUR LEVEL (ppmv)							
				10	100	1000	10000				
0.0 - 0.1	●	ASPHALT								roadbox, jplug, cement	
0.1 - 1.0	●	SAND (FILL)	Fine to medium-grained, some fine to course-grained sub-rounded gravel, grey, damp							backfilled with silica sand	
1.0 - 2.0	●	SAND AND GRAVEL (FILL)	Medium-grained sand, fine to course-grained sub-rounded gravel, trace cobbles and silt, debris, reddish brown, damp								
2.0 - 3.1	×	SILTY SAND (Native)	Fine-grained, trace to some sub-angular gravel, grey, damp							BETX/VPH	
3.1 - 3.8	×		- moist at approximately 2.1 m							bentonite seal	
3.8 - 5.0	×									silica sand	
5.0 - 6.1	×									3.80 m (16/08/01)	
6.1 - 6.6	×									50 mm Ø10 slot PVC pipe	
6.6 - 6.9	×										

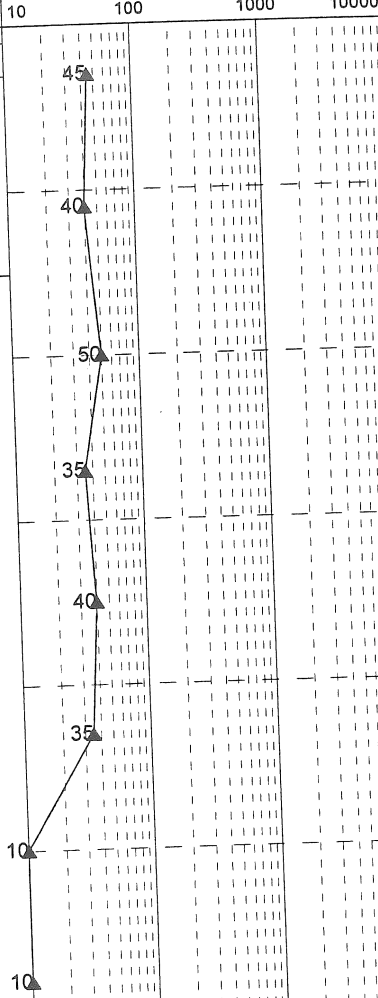

End of borehole at 6.1 m  
Screened interval from 3.1 m to 6.1 m  
Elevation at top of piezometer (TOP) = 30.91 m  
Depth to groundwater from TOP = 3.80 m (16/08/01)