PITEAU ASSOCIATES
Geotechnical and Hydrogeological Consultants
Vancouver Lima

LOG OF MW02-04

(Page 1 of 1)

NEW EAST CONSULTING SERVICES LTD.
HYDROGEOLOGIC AND GEOTECHNICAL
ASSESSMENT OF CITY LANDS
190-194 ST. & 20 28 AVE.
CAMPBELL HEIGHTS, SURREY, B.C.

Contractor	: Backhoes Unlimited	Project number	2460
Excavation method	Backhoe	Borehole location	: See Fig. 2
Project supervisor	: Allan Dakin	Sample method	: Grab
Field engineer	: Ben McGuffie	Casing stick up	0.50m
Date	November 28, 2002		

Depth in meters	DESCRIPTION	GRAPHIC	REMARKS
0	light grey-brown silty CLAY, moist, soft		
.5			
1			
1.5			
2			
2.3m	grey SAND, trace gravel, moist to saturated loose		Water level December 6, 2002 2.81m below top of PVC
2.5			Screen 0.76m in length
3	3.1m End of excavation		
3.5			
4			
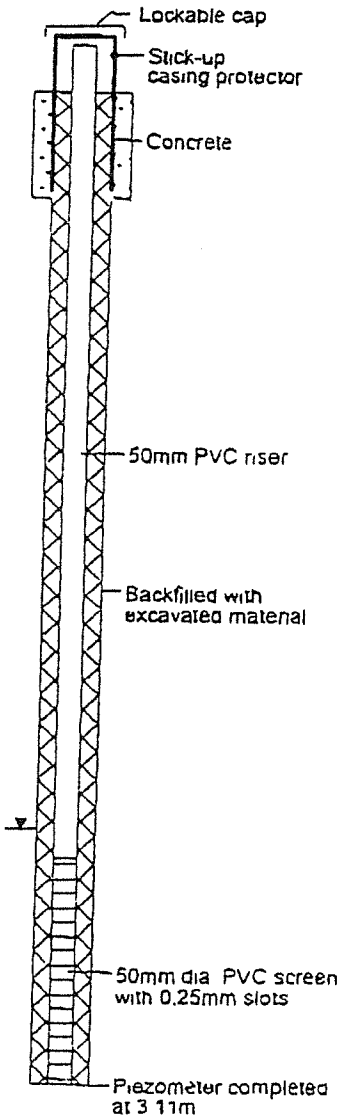
Top of PVC Elevation N/A