



Client:
Shell Canada Products

Borehole No. : 03-7


Location:
Lot 145, Northwest corner of 201A Street & Fraser Highway, Langley, BC

(Page 1 of 1)

Drilling Contractor: Uniwide Drilling Co. Ltd.
Drilling Method : Solid Stem Auger
Borehole Dia. (m) : 0.15
Pipe/Slotted Pipe Dia. (m): 0.05, 0.05

Date Monitored : 2004 09 02
Ground Surf Elev. (m) : 12.179
Top of Casing Elev. (m) : 12.072

Project Number : V8167
Borehole Logged By : RRW
Date Drilled : 2003 02 06
Log Typed By : APC

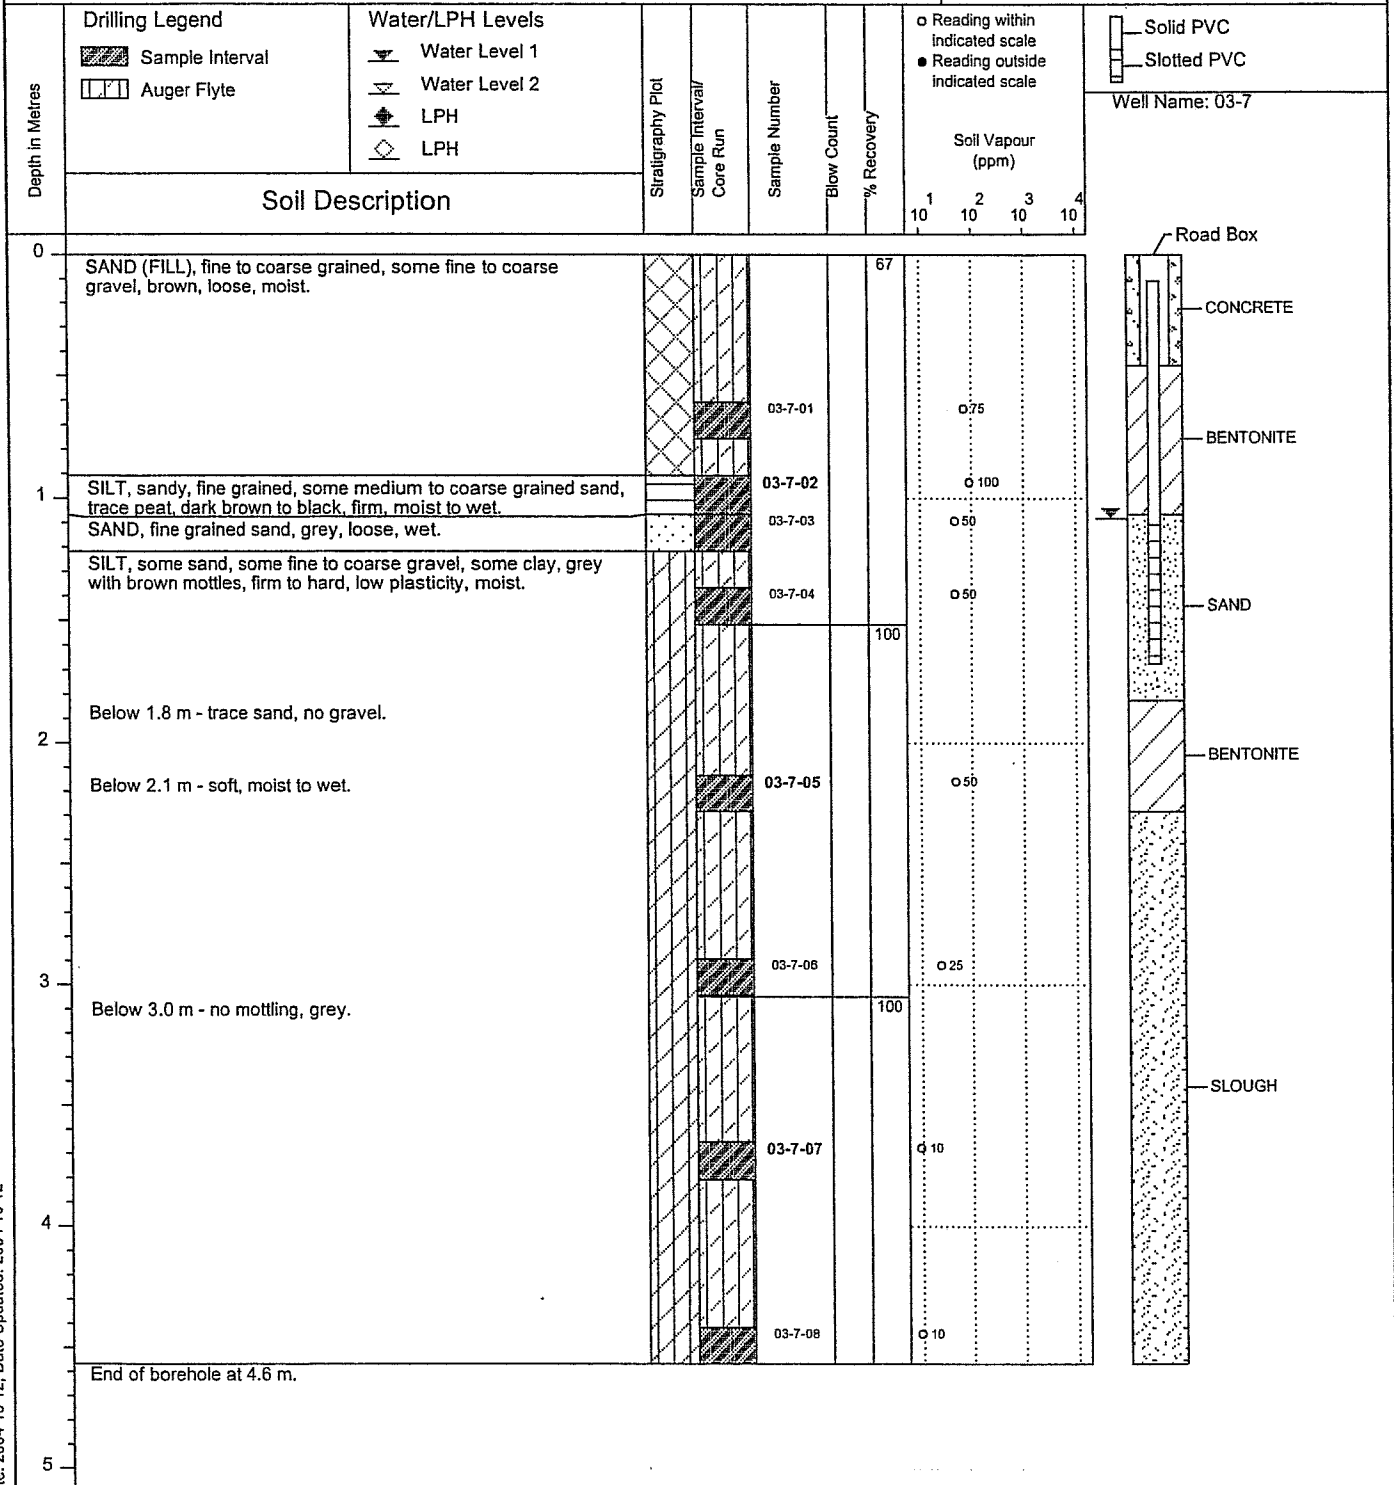

Notes:
Bolded sample denotes sample analyzed.