


PROJECT: STAGE 2 PSI and DSI	CLIENT: R421 ENTERPRISES LTD.	BOREHOLE NO: 8840206.1-MW-102
LOCATION: 1980 BREDIN ROAD	CONTRACTOR: GEOTECH DRILLING SERVICES	PROJECT NO: 808-8840206.001
KELOWNA, BC	EQUIPMENT: ODEX TRUCK MOUNTED DRILL RIG	ELEVATION: 99.69 m

SAMPLE TYPE	<input checked="" type="checkbox"/> GRAB	<input checked="" type="checkbox"/> SPT SPLIT SPOON
BACKFILL TYPE	<input checked="" type="checkbox"/> BENTONITE	<input type="checkbox"/> PEA GRAVEL
	<input type="checkbox"/> SLOUGH	<input type="checkbox"/> GROUT
	<input type="checkbox"/> DRILL CUTTINGS	<input type="checkbox"/> SAND

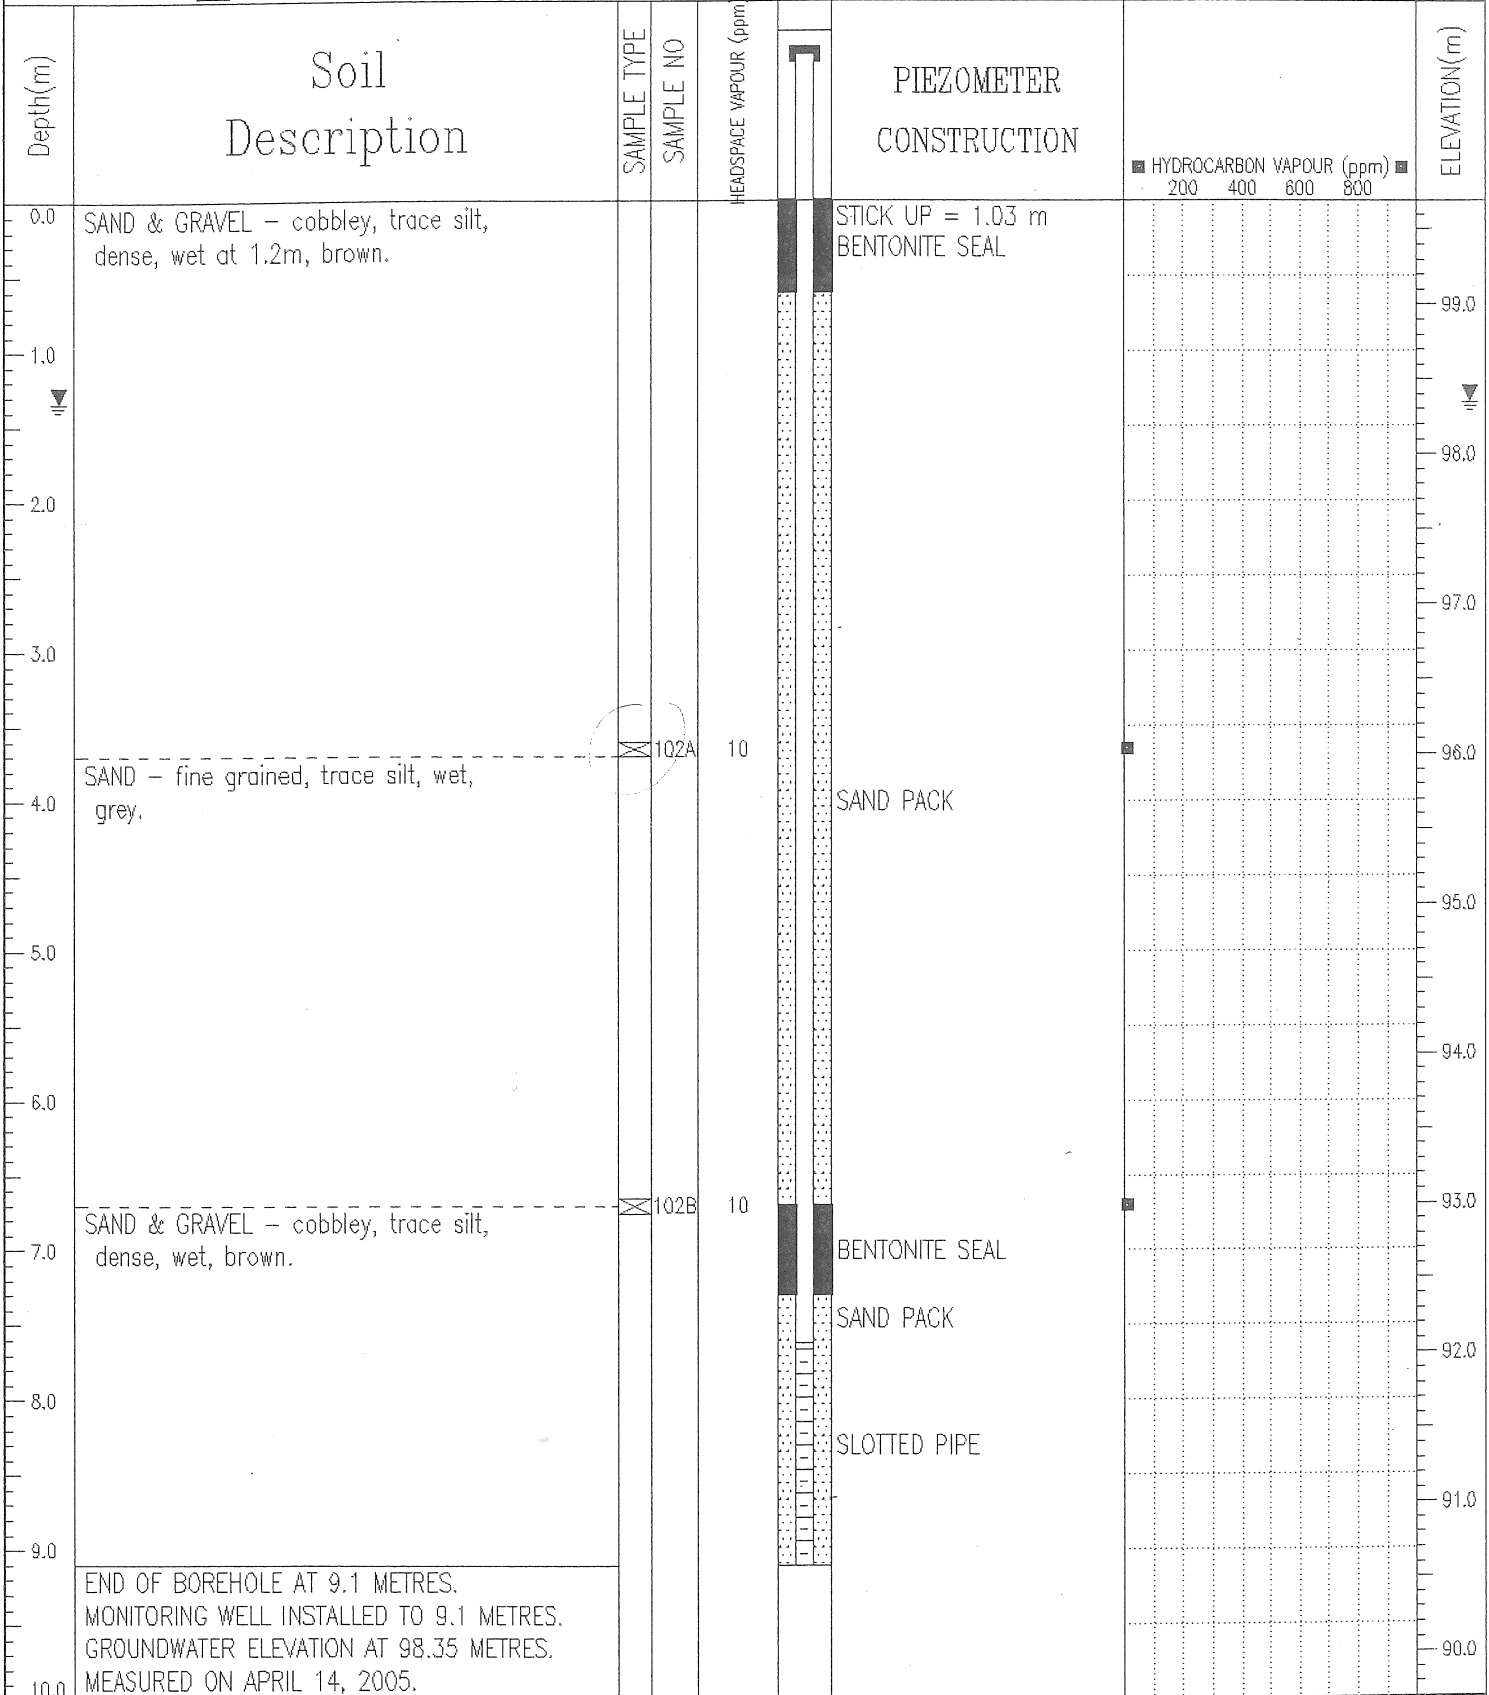

EBA Engineering Consultants Ltd.  
Kelowna, B.C.

LOGGED BY: RT	COMPLETION DEPTH: 9.1 m
REVIEWED BY: RT/DT	COMPLETE: 17/03/05
Fig. No: BH-102	Page 1 of 1