



SNC-LAVALIN
Environment

Client :
Shell Canada Products

Borehole No. : 05-28S/D

Location :
Mt. Lehman and Fraser Highway, Abbotsford, BC


(Page 1 of 1)

Drilling Contractor: Uniwide Drilling Co. Ltd.
Drilling Method : Vacuum Truck/Solid Stem Auger
Borehole Dia. (m) : 0.15
Pipe/Slotted Pipe Dia. (m): 0.05, 0.05

Date Monitored : 2005 05 24
Ground Surf Elev. (m) : 92.851
Top of Casing Elev. (m) : 92.716, 92.747

Project Number : 130367
Borehole Logged By : GRW
Date Drilled : 2005 05 17
Log Typed By : PKR

Depth in Metres	Drilling Legend	Water/NAPL Levels	Stratigraphy Plot	Sample Interval/ Core Run	Sample Number	Blow Count	% Recovery	Soil Vapour (ppm)				Well Name: 05-28S Well 2 Name: 05-28D	
								1	2	3	4		
0	ASPHALT. ROAD FILL.												
1	SANDY SILT, fine grained, trace fine gravel, subrounded, grey, plastic, moist. At 1.2 m - saturated.			28-1				0.25					
2				28-2		100		0.25					
3	SILTY CLAY, grey, medium plasticity, moist.			28-3				0.25					
4				28-4				0.25					
5				28-5		100		0.25					
6	End of borehole at 6.1 m.			28-6				0.25					

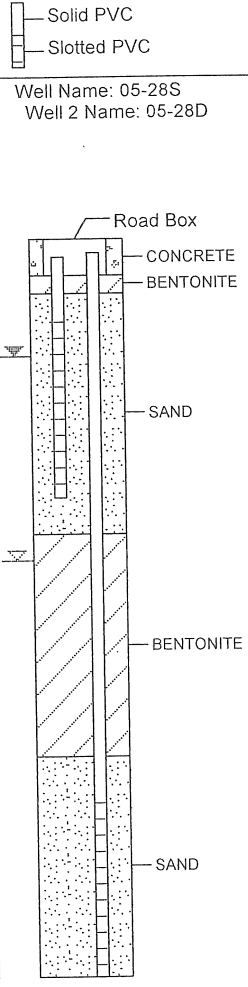

Notes:
Bolded sample denotes sample analyzed.