


2285 - 5 SQUARES
 50286 - 5 SQUARES
 3-0237 - 5 SQUARES
 3-0197 - 5 SQUARES
 200 SHEETS - FILLER

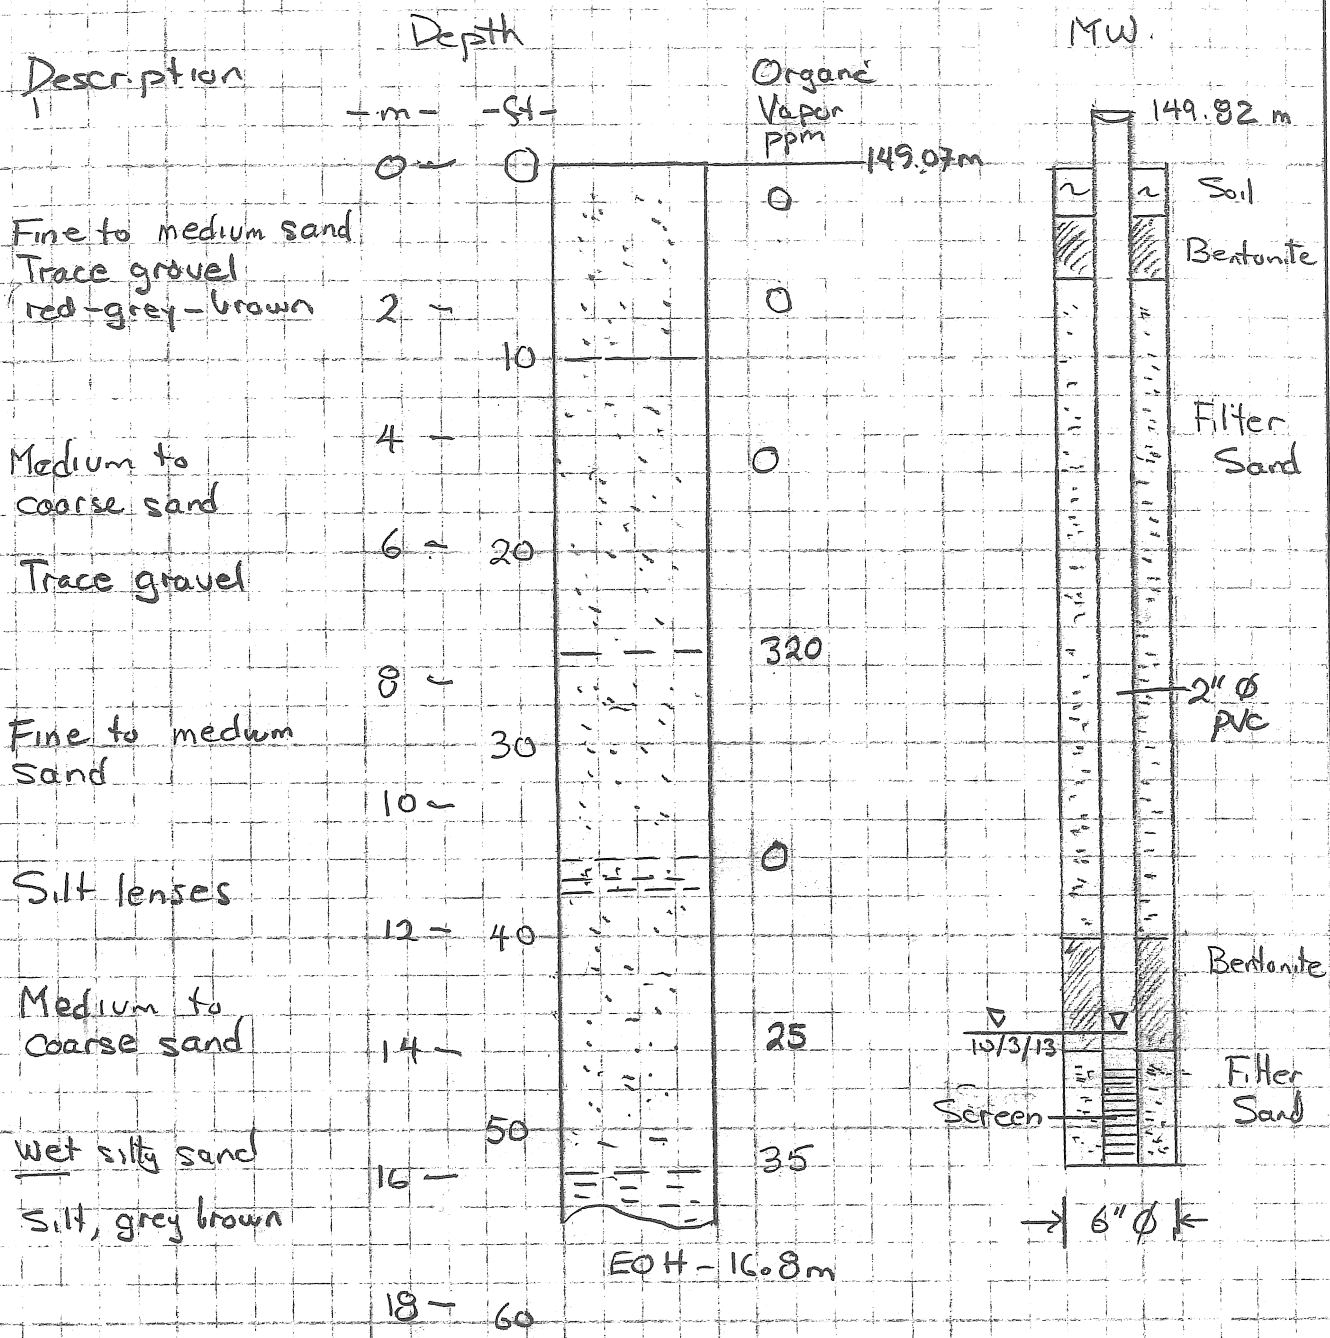

Drilled 9/18/13
 by Mud Bay
 DB 320
 Sonic Drill Rig

Logged By David Graham H&E 9/18/13