



SNC-LAVALIN
Environment

Client :
Shell Canada Products

Borehole No. : BH11-137DD


Location :
Mall (Westshore Town Centre), Langford, BC

(Page 1 of 1)

Drilling Contractor: Beck Drilling and Environmental Services Ltd.
Drilling Method : Hydrovac/Hollow Stem Auger
Borehole Dia. (m) : 0.20
Pipe/Slotted Pipe Dia. (m): 0.05, 0.05

Date Monitored : 2011 08 04
Ground Surf Elev. (m) : 63.56
Top of Casing Elev. (m) : 63.49
Northing: 5367445.8 Easting: 462478.96

Project Number :504604
Borehole Logged By :MMJ/PKS
Date Drilled :2011 07 28
Log Typed By :MAL

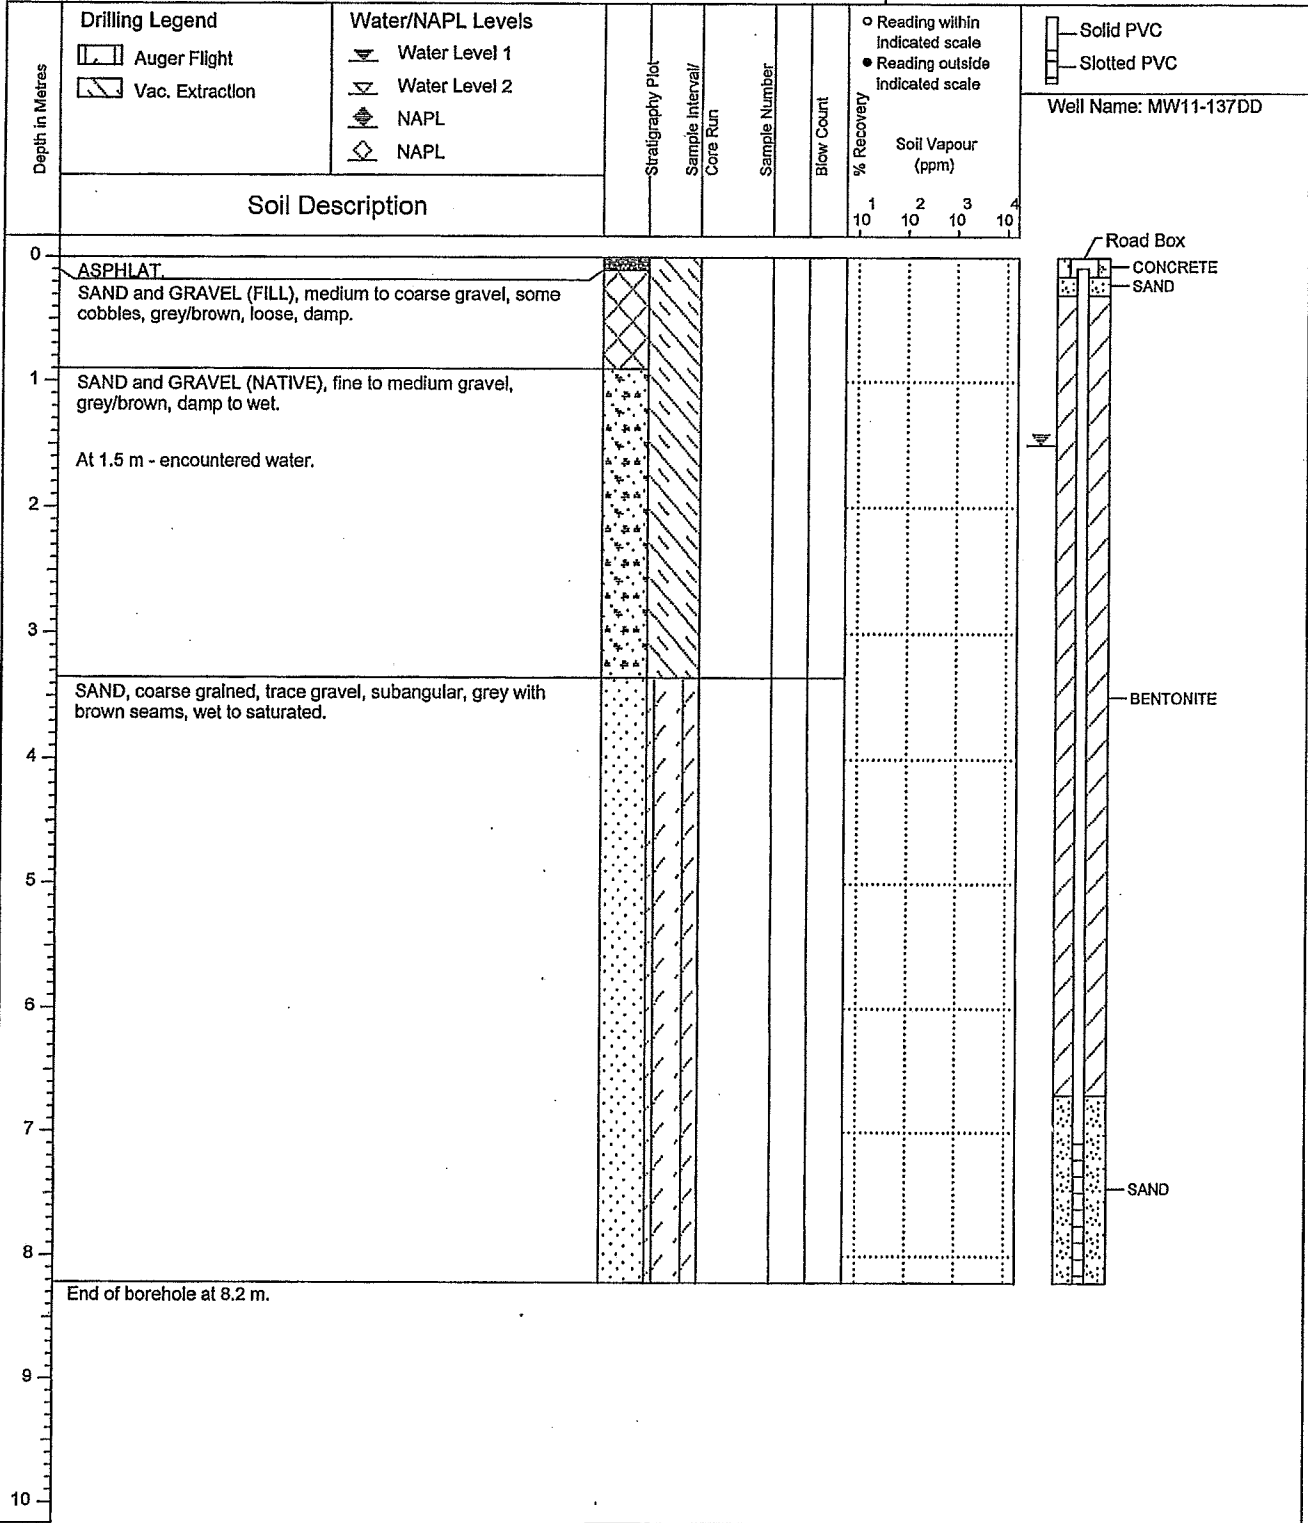

Notes:
Borehole day-lighted to a depth of 3.4 m on 2011 07 28.

Print Date: 2013 01 24, Date Approved: 2013 01 24