

EXAMINATION
SKETCH

BRITISH COLUMBIA LAND SERVICE
SURVEYS AND MAPPING BRANCH
LEGAL SURVEYS DIVISION

0207987

Victoria File

924.053

Request No.

3A (A-B)

Reference Map

Description of Area: *Unsurveyed area within Sec. 13, Rupert, Formerly Quatsino, Dist.
Subject to Survey*

Location: *South East of Quatsino, on Atkins Bay*


Rupert
Comex

Land District
Assessment District

Vancouver

Forest District
Land Inspection District
Ranger District

Scale: 20 chrs. = 1 inch

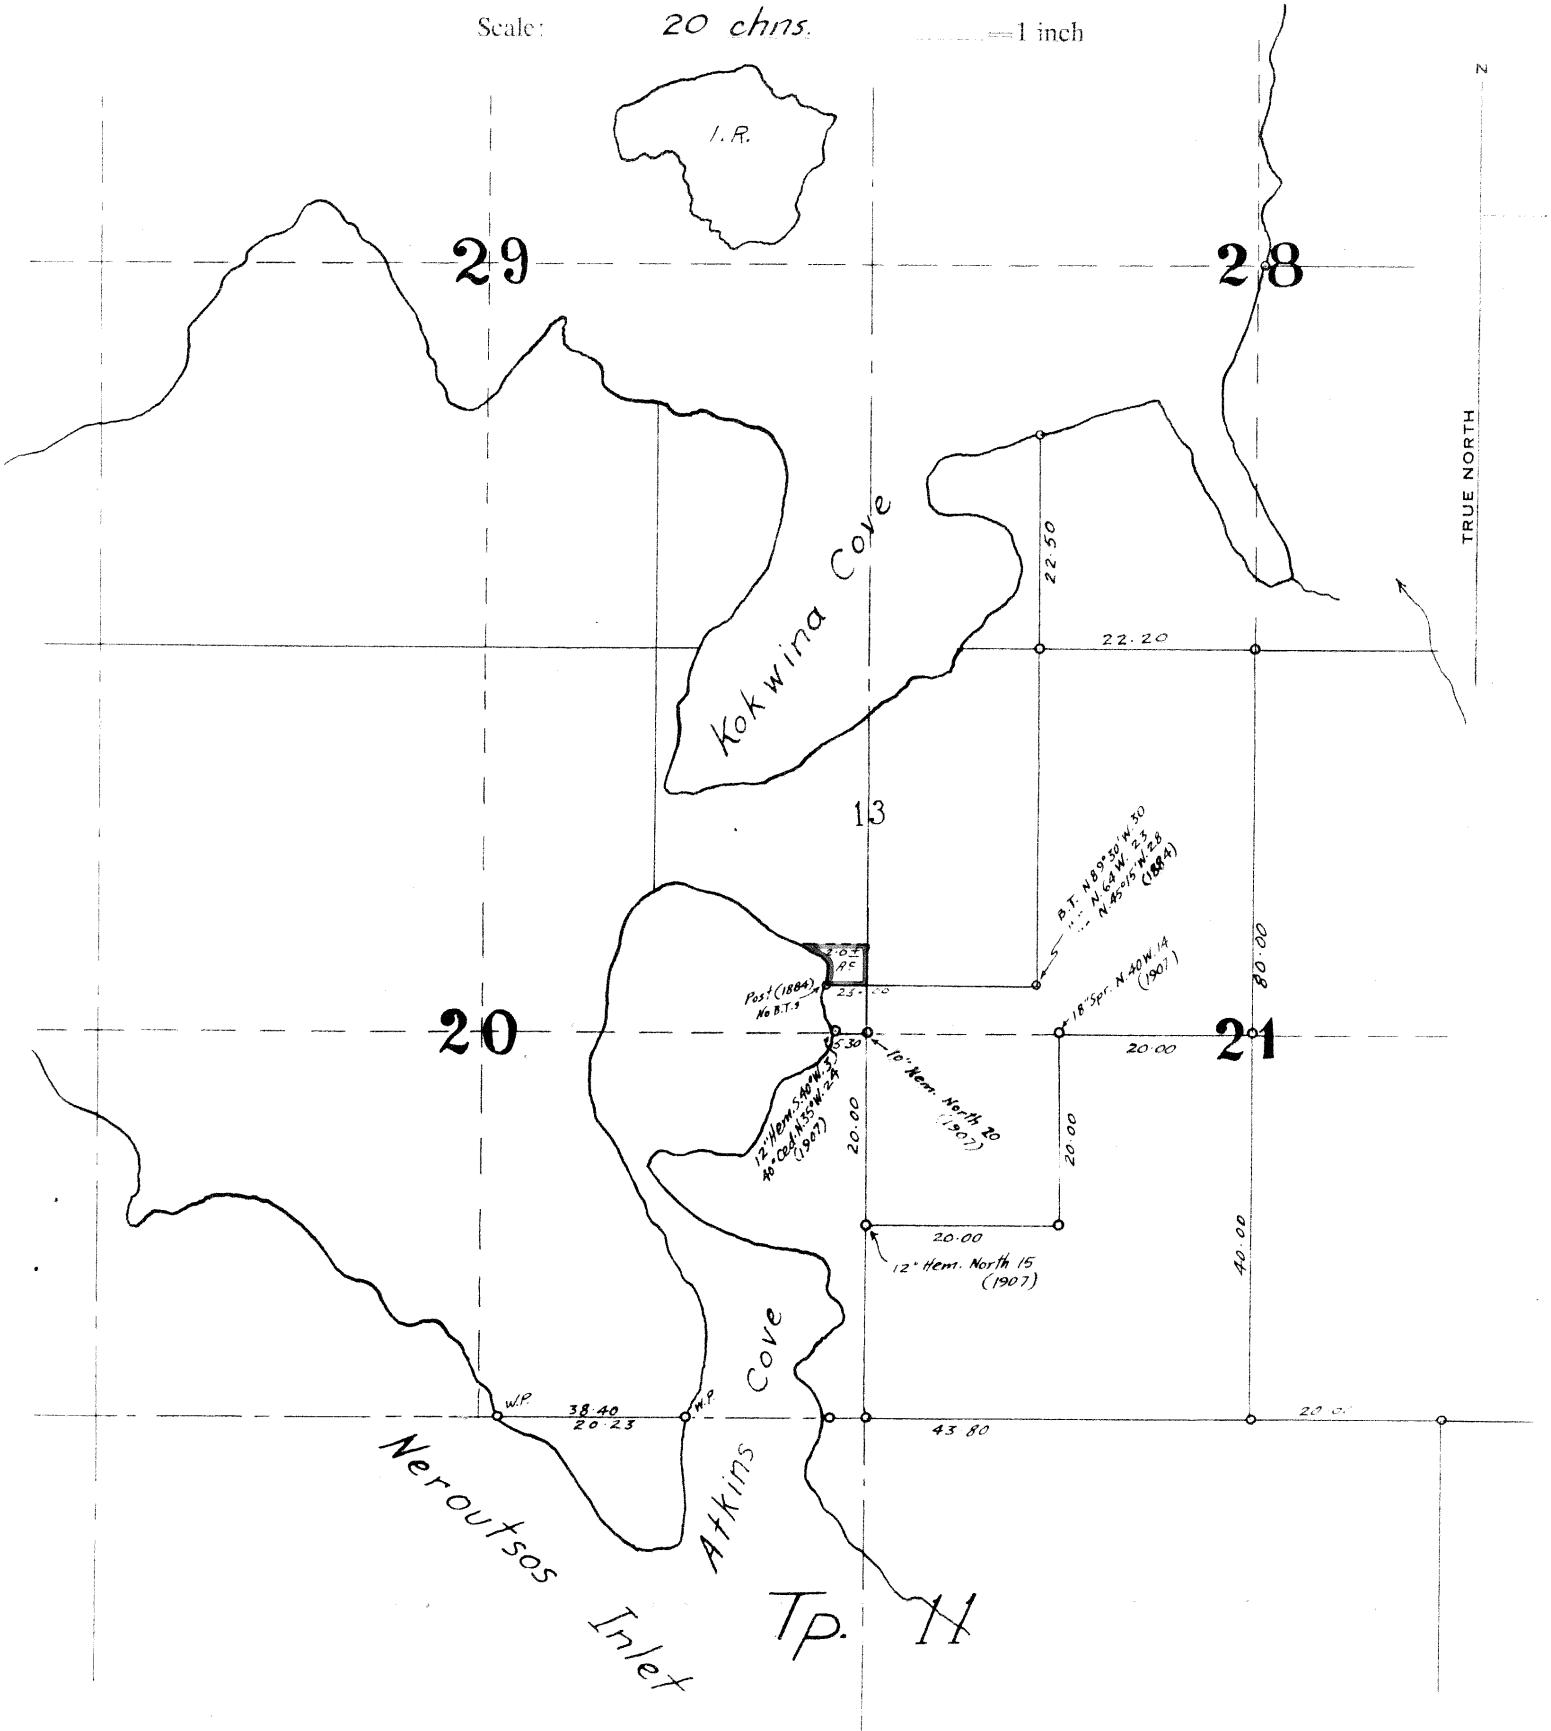

Lot No.	Field Book	P.H.	Surveyed By	Date Surveyed	Plan	Air Photo
Sec. 21 Tp. 11	186/08	5	J.H. McGregor	Sept 1907	77.1, 11 T. 2	
Sec. 13 "	684/84	1	E. Stephens	Aug. 1884		
					Made by <i>J.E. Jones</i>	Date <i>Aug. 5/55</i>