PROVINCE OF BRITISH COLUMBIA

Department of Lands, Forests, and Water Resources

FOREST SERVICE

IN THE MATTER OF TREE FARM LICENCE NUMBER 19

AMENDMENT NUMBER 15

Whereas certain lands hereinafter described are within Tree Farm Licence Number 19 and are found to be suitable for a higher economic use than growing forest crops.

And whereas the withdrawal of the aforementioned lands will in no way affect the sustained yield management of the said Tree Farm Licence.

Therefore pursuant to Subsection (14) Section 36 of the Forest Act being Chapter 153 of the Revised Statutes of British Columbia 1960 and Clause 12 of the said Tree Farm Licence the Licensor hereby consents to the withdrawal of the following lands from the lands described in Schedule "A" of the said Tree Farm Licence; that is to say that part of Lot 6 Nootka Land District shown outlined in red on the plan attached hereto and being more particularly described as follows:

> "Commencing at the initial post of Lot 175 Nootka District being an angle near the southern extremity of the Lot; thence north along the west boundary of Lot 175, 1,329 feet; thence west along the south boundary of Lot 175, 663 feet to corner No. 2 of Lot 175; thence west 385 feet; thence south 660 feet more or less to a point on the east bank of Gold River; thence southerly along the east bank of Gold River to a point due west of the aforesaid initial post of Lot 175; thence east 1,048 feet more or less to the point of commencement; the resultant area being approximately 32 acres."

and the said lands so withdrawn are not and shall not be henceforth part of or subject to the said Tree Farm Licence.

Dated at the City of Victoria in the Province of British Columbia this 24th day of FEBRUARY 1965.

Ray Williston

Minister of Lands, Forests, and Water Resources

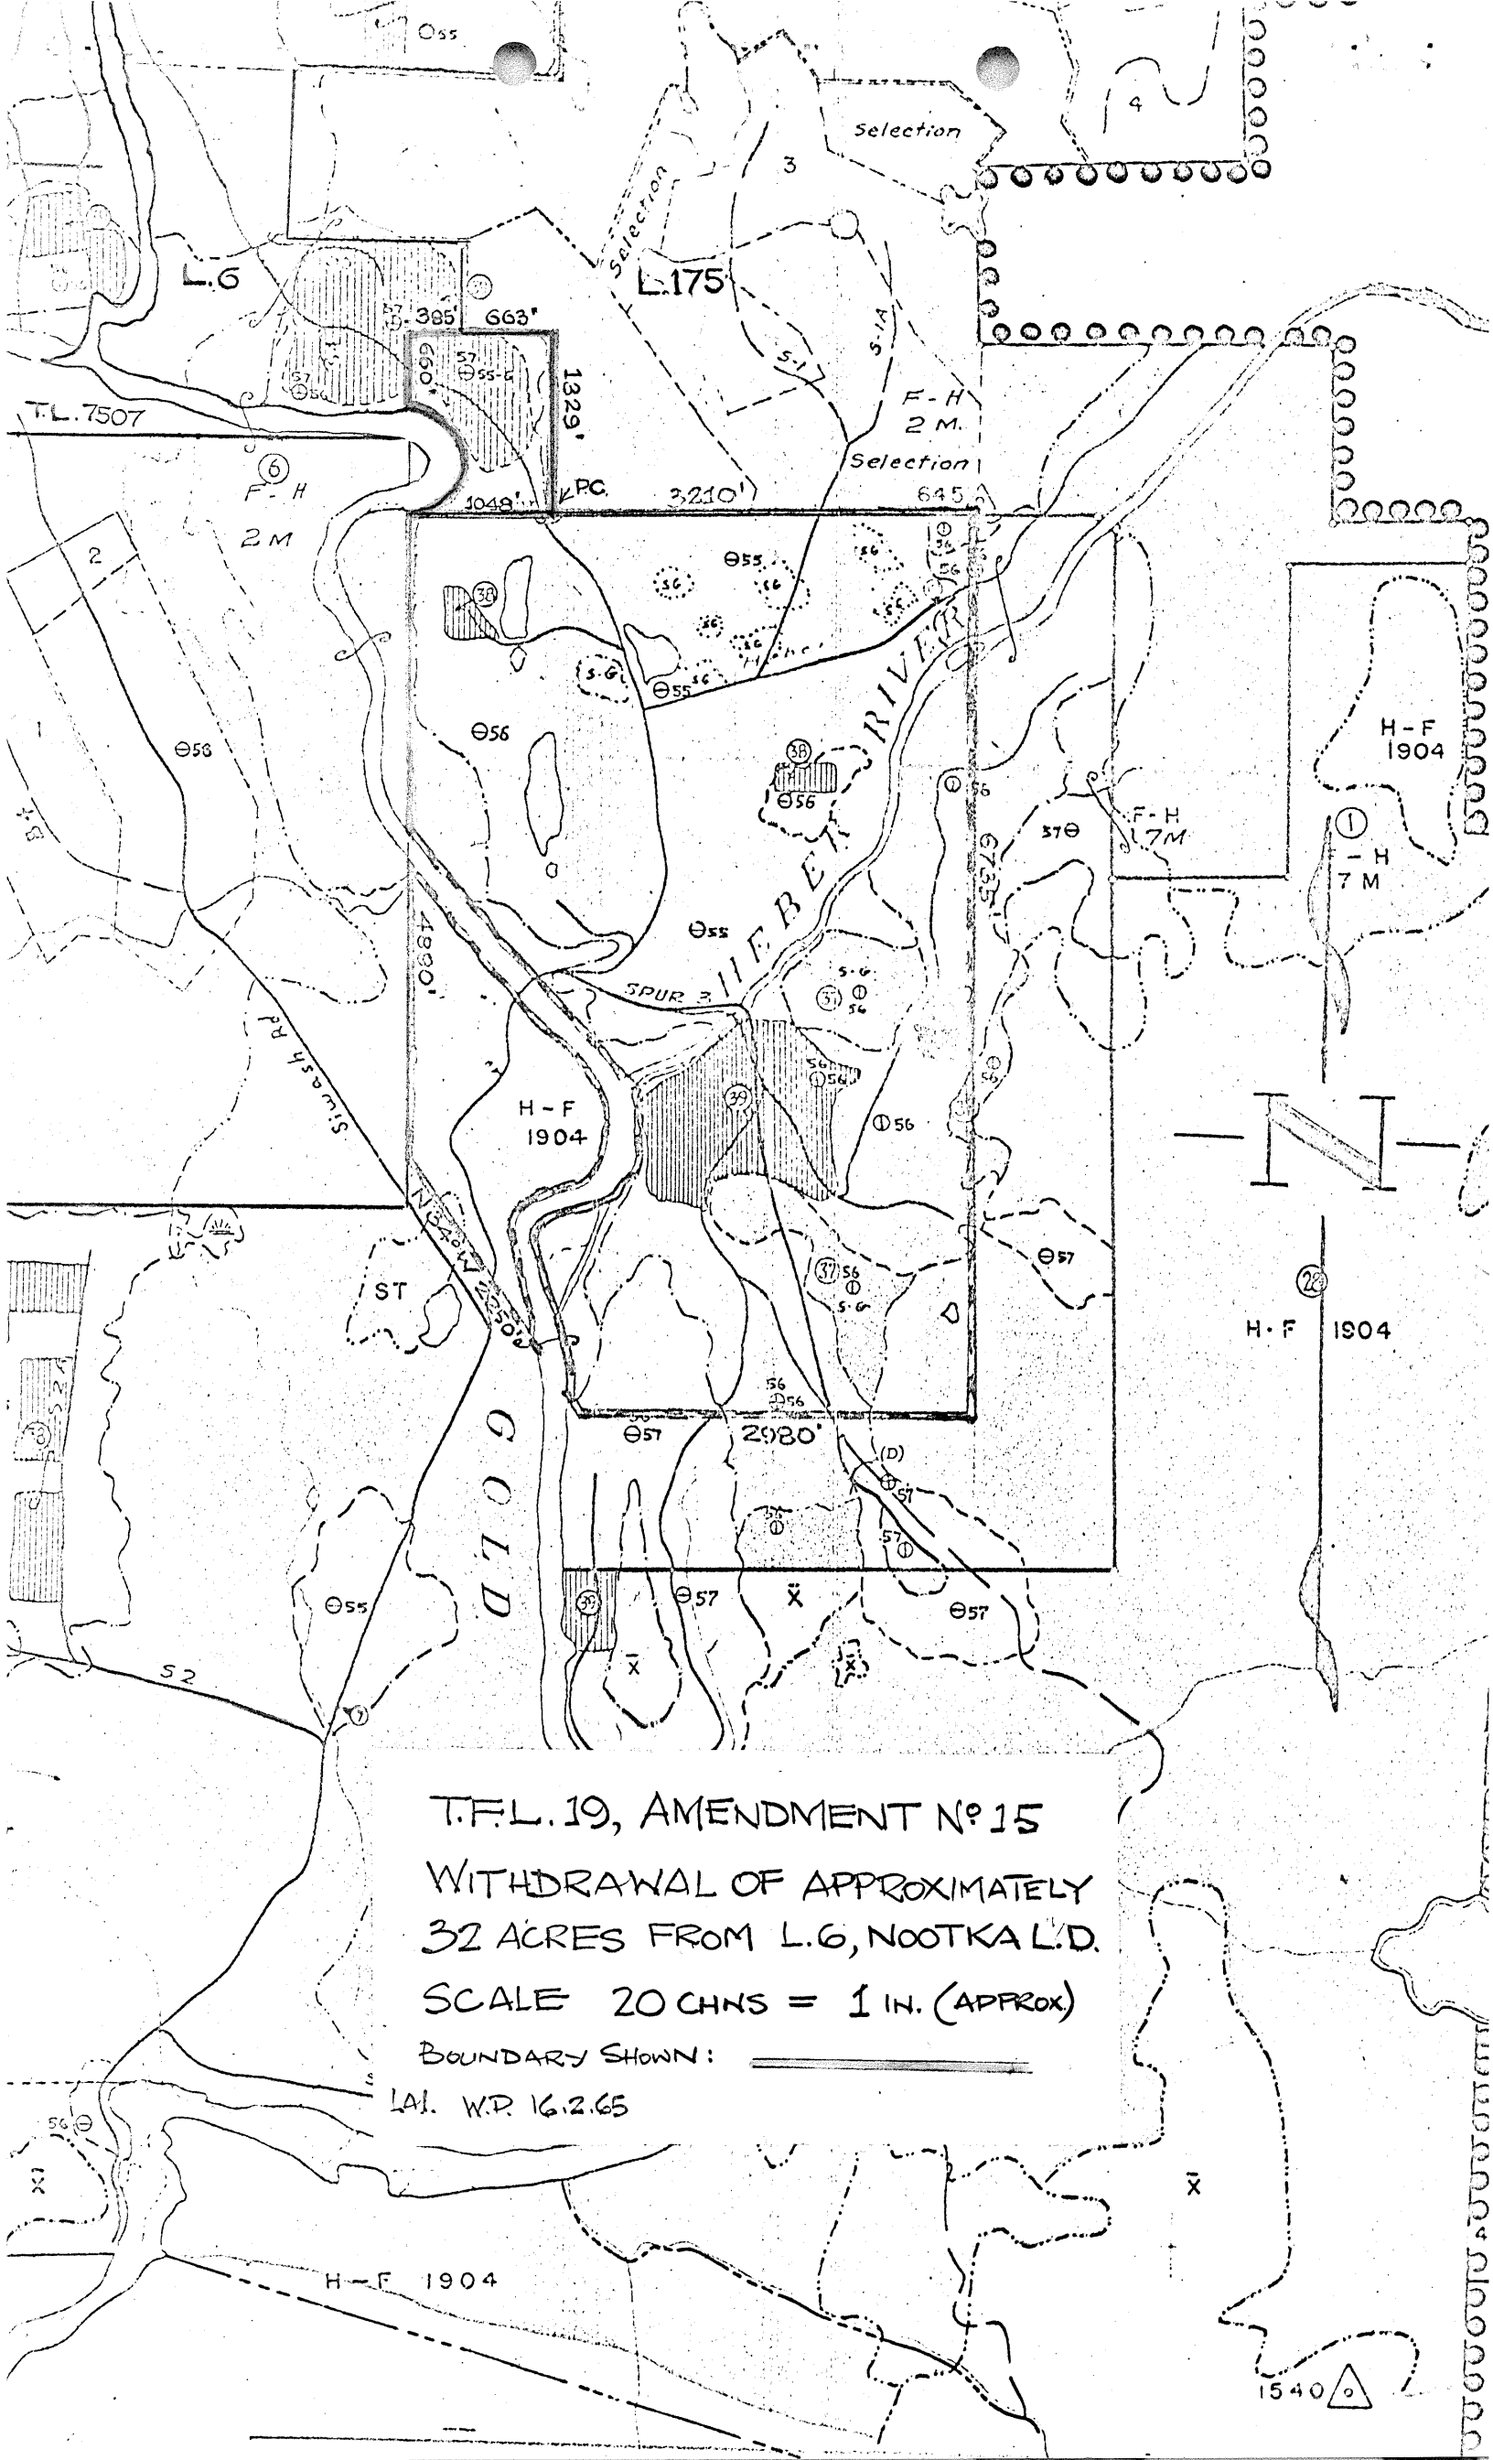

T.F.L. 19, AMENDMENT Nº 15

WITHDRAWAL OF APPROXIMATELY 32 ACRES FROM L.6, NOOTKA L.D.

SCALE 20 CHNS = 1 IN. (APPROX)

BOUNDARY SHOWN: ———

L.A.I. W.P. 16.2.65