PROVINCE OF BRITISH COLUMBIA

Department of Lands, Forests, and Water Resources

FOREST SERVICE

---

IN THE MATTER OF TREE FARM LICENCE NUMBER 19

AMENDMENT NUMBER 33

---

Whereas the lands described hereinafter are within Tree Farm Licence Number 19 and are found to be suitable for a higher economic use than the growing of forest crops;

And whereas the withdrawal of the aforementioned lands together with any lands previously withdrawn does not diminish the productive capacity of the licence area to the extent provided in Clause 9 of the Tree Farm Licence;

Therefore pursuant to Subsection (14) of Section 36 of the Forest Act being Chapter 153 of the Revised Statutes of British Columbia, 1960, and pursuant to Clause 9 of the said Tree Farm Licence, the following lands are herewith withdrawn from the lands described in Schedule "B" of the said Tree Farm Licence; namely, all that parcel or tract of land being more particularly shown in bold black on the sketch attached hereto and described as follows:

> "Commencing at the Southeast corner of Lot 639, Nootka Land District, thence South 19 chains to the Ucona Logging Road; thence Northwesterly along the Ucona Logging Road to the South boundary of Lot 637; thence East 14 chains to the point of commencement; containing 10 acres, more or less, for gravel pit purposes."

and the said lands so withdrawn are and shall be henceforth no longer subject to or form any part of the said Tree Farm Licence Number 19, during the term of Special Use Permit Number 6163, issued in respect of the aforementioned gravel pit.

Dated at the City of Victoria in the Province of British Columbia this . . . 3rd . . . day of . . . . July . . . . . , 1968.

Ray Williston

Minister of Lands, Forests, and Water Resources

BRITISH COLUMBIA

# FOREST SERVICE

## Amendment No. 33 to T.F.L. 19 (shown thus ~)
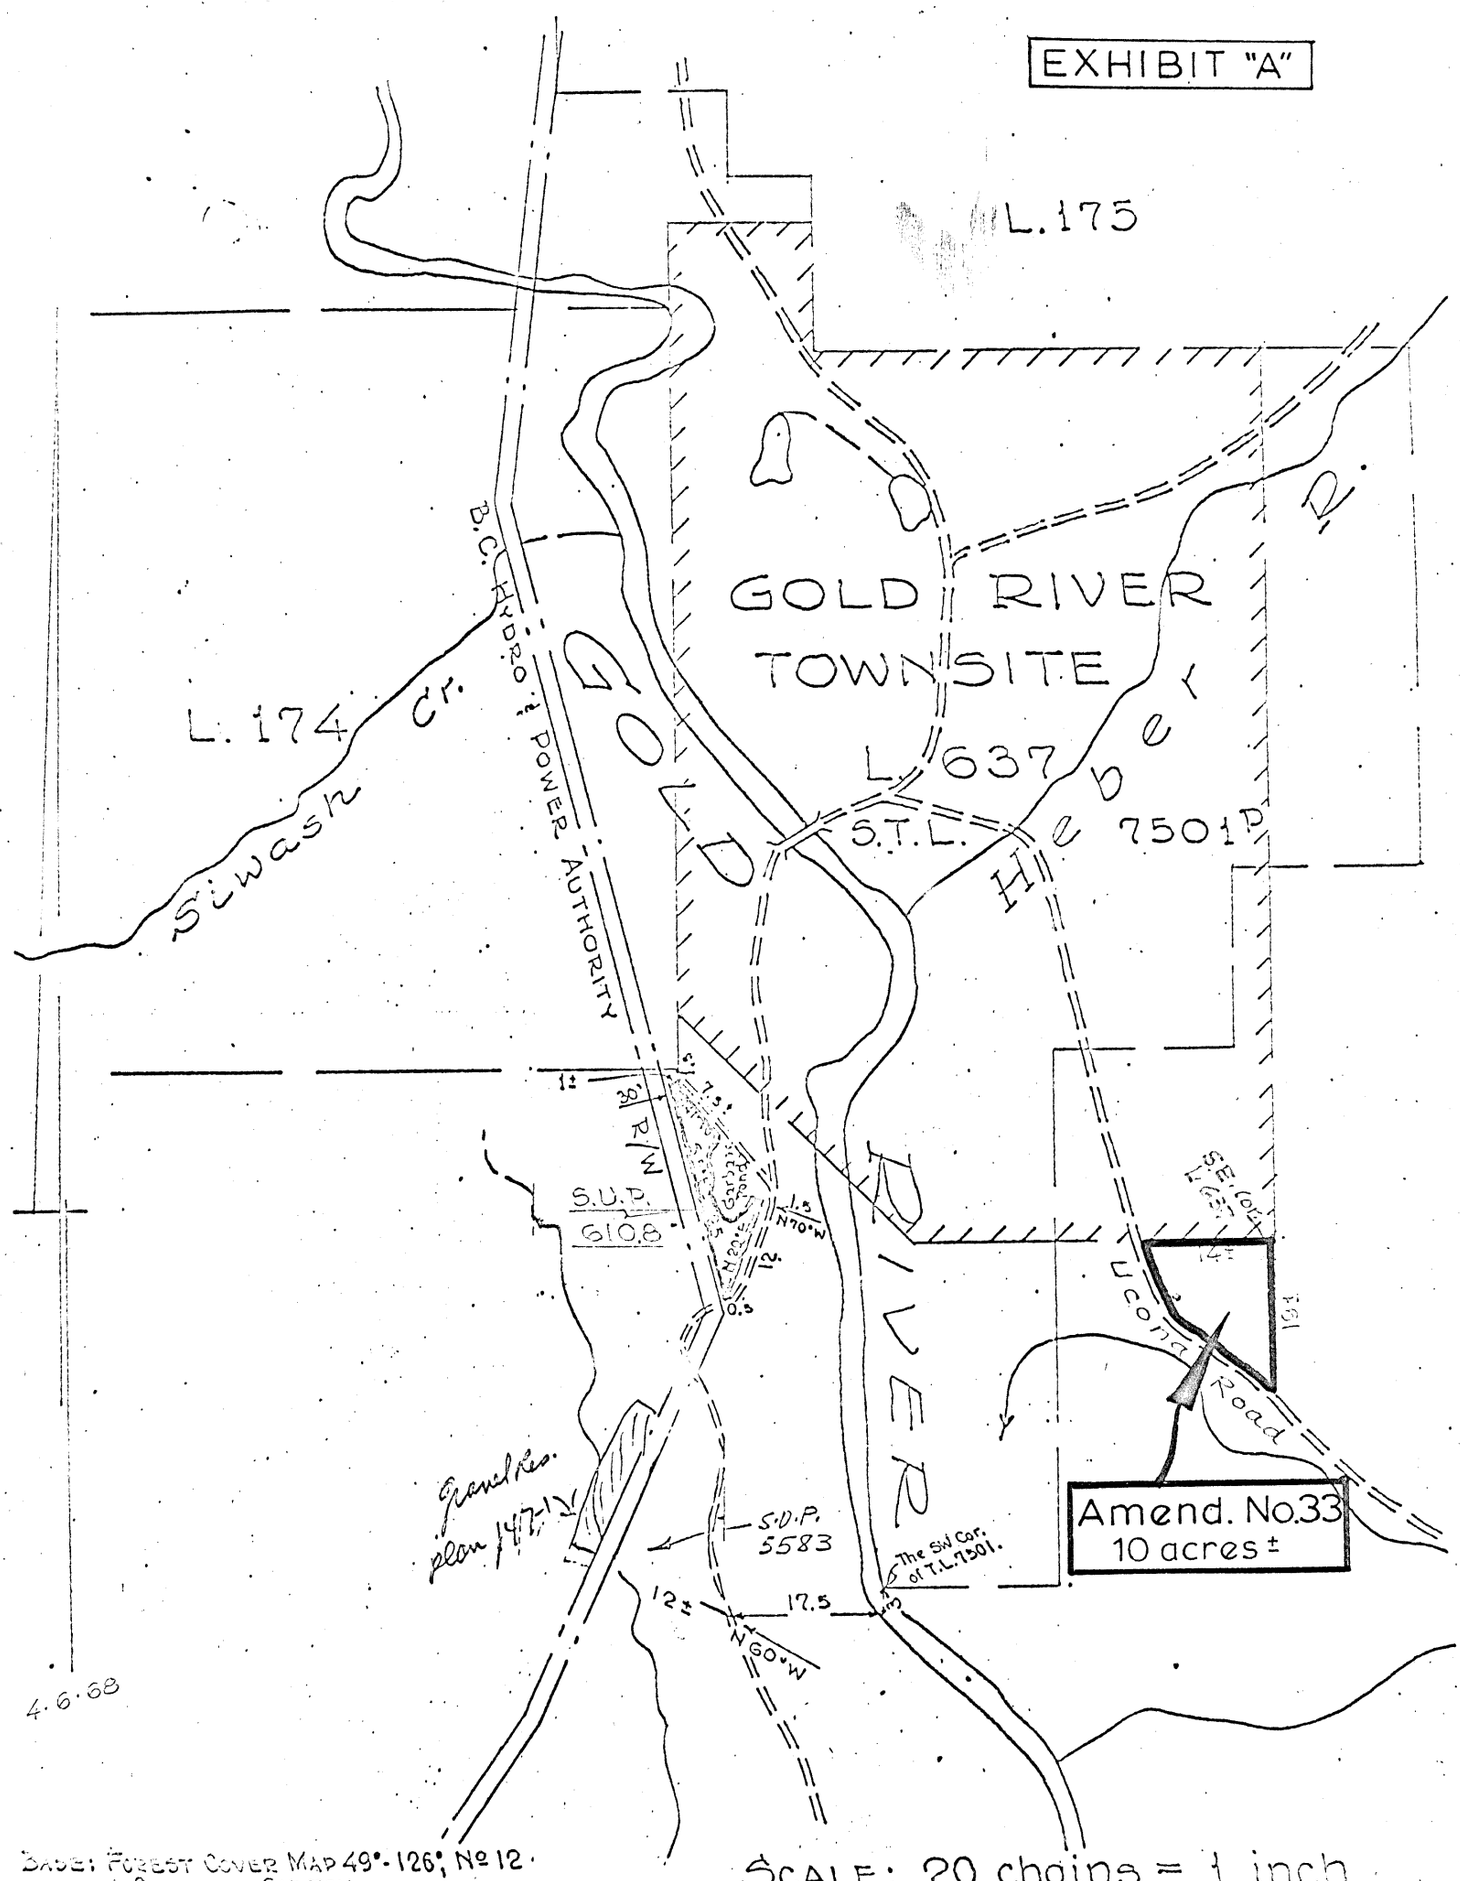
10 acre Gravel Pit — Scale: 20 chains = 1 inch