



THE GOVERNMENT OF
THE PROVINCE OF BRITISH COLUMBIA

FOREST SERVICE

OFFICE OF
THE DEPUTY MINISTER
VICTORIA, B.C.

January 14th, 1976

File: TFL 19 Sec. 7B

MEMORANDUM TO THE HONOURABLE THE MINISTER

The Corporation of the Village of Zeballos has requested that approximately 83 acres within the Village boundaries be removed from Tree Farm Licence No. 19 and placed under Village control and administration for future Village requirements.

Since the Village is enclosed by Tree Farm Licence No. 19 (Tahsis Co. Ltd.) it is recommended that you sign the attached Instrument in duplicate.

Once the area is removed from the Tree Farm Licence it will be incumbent on the Village Council to apply for tenure under the Land Act. The Department could then prepare the necessary Order-in-Council to lift the parcel from the Kyuquot Forest Reserve.


J. S. Stokes,
Deputy Minister.

1.3 This has now been discussed with the TFL holders and they have no objection to the withdrawal of the

PROVINCE OF BRITISH COLUMBIA

Department of Forests

FOREST SERVICE

IN THE MATTER OF TREE FARM LICENCE NUMBER 19

INSTRUMENT NUMBER 48

Amendment

Whereas the lands described hereinafter are within Tree Farm Licence Number 19 and are found to be suitable for a higher economic use than the growing of forest crops;

And whereas the withdrawal of the aforementioned lands together with any lands previously withdrawn does not diminish the productive capacity of the licence area to the extent provided in Clause 9 of the Tree Farm Licence;

Therefore pursuant to Subsection (14) of Section 36 of the Forest Act, and pursuant to Clause 9 of the said Tree Farm Licence the following lands are herewith withdrawn from the lands described in Schedule "B" of the said Tree Farm Licence; namely, all that parcel or tract of land being more particularly shown in bold black on the sketch attached hereto and described as follows:

"Commencing at a point on the east side of the Zeballos main road, said point being 6 chains south and 4 chains east of the north west corner of Lot 485 Nootka Land District; thence east 7 chains more or less to the Zeballos River; thence southerly and westerly following the highwater mark of the Zeballos River and Zeballos Inlet to a point 39 chains south and 25 chains west of the point of commencement; thence west to the Zeballos main road; thence north easterly along the said road to a point of commencement, containing 83 acres more or less."

and the said lands so withdrawn are and shall be henceforth no longer subject to or form any part of the said Tree Farm Licence Number 19.

Dated at the City of Victoria in the Province of British Columbia this *2nd* . . . day of . . . *FEBRUARY* , 1976.


Minister of Forests

LAND DISTRICT NOOTKA
Region No. 3 Compt. No. 12C
Base OFFICIAL & T.F.L.


BRITISH COLUMBIA

FOREST SERVICE

EXHIBIT A
Date JAN. 29, 1975
Atlas Ref. 92 E/NE(d-4)

INSTRUMENT NO 48 TO T.F.L. 19

Shown _____ Acres+ 83.0 R.D. 28 Scale 20 chs. = 1 inch

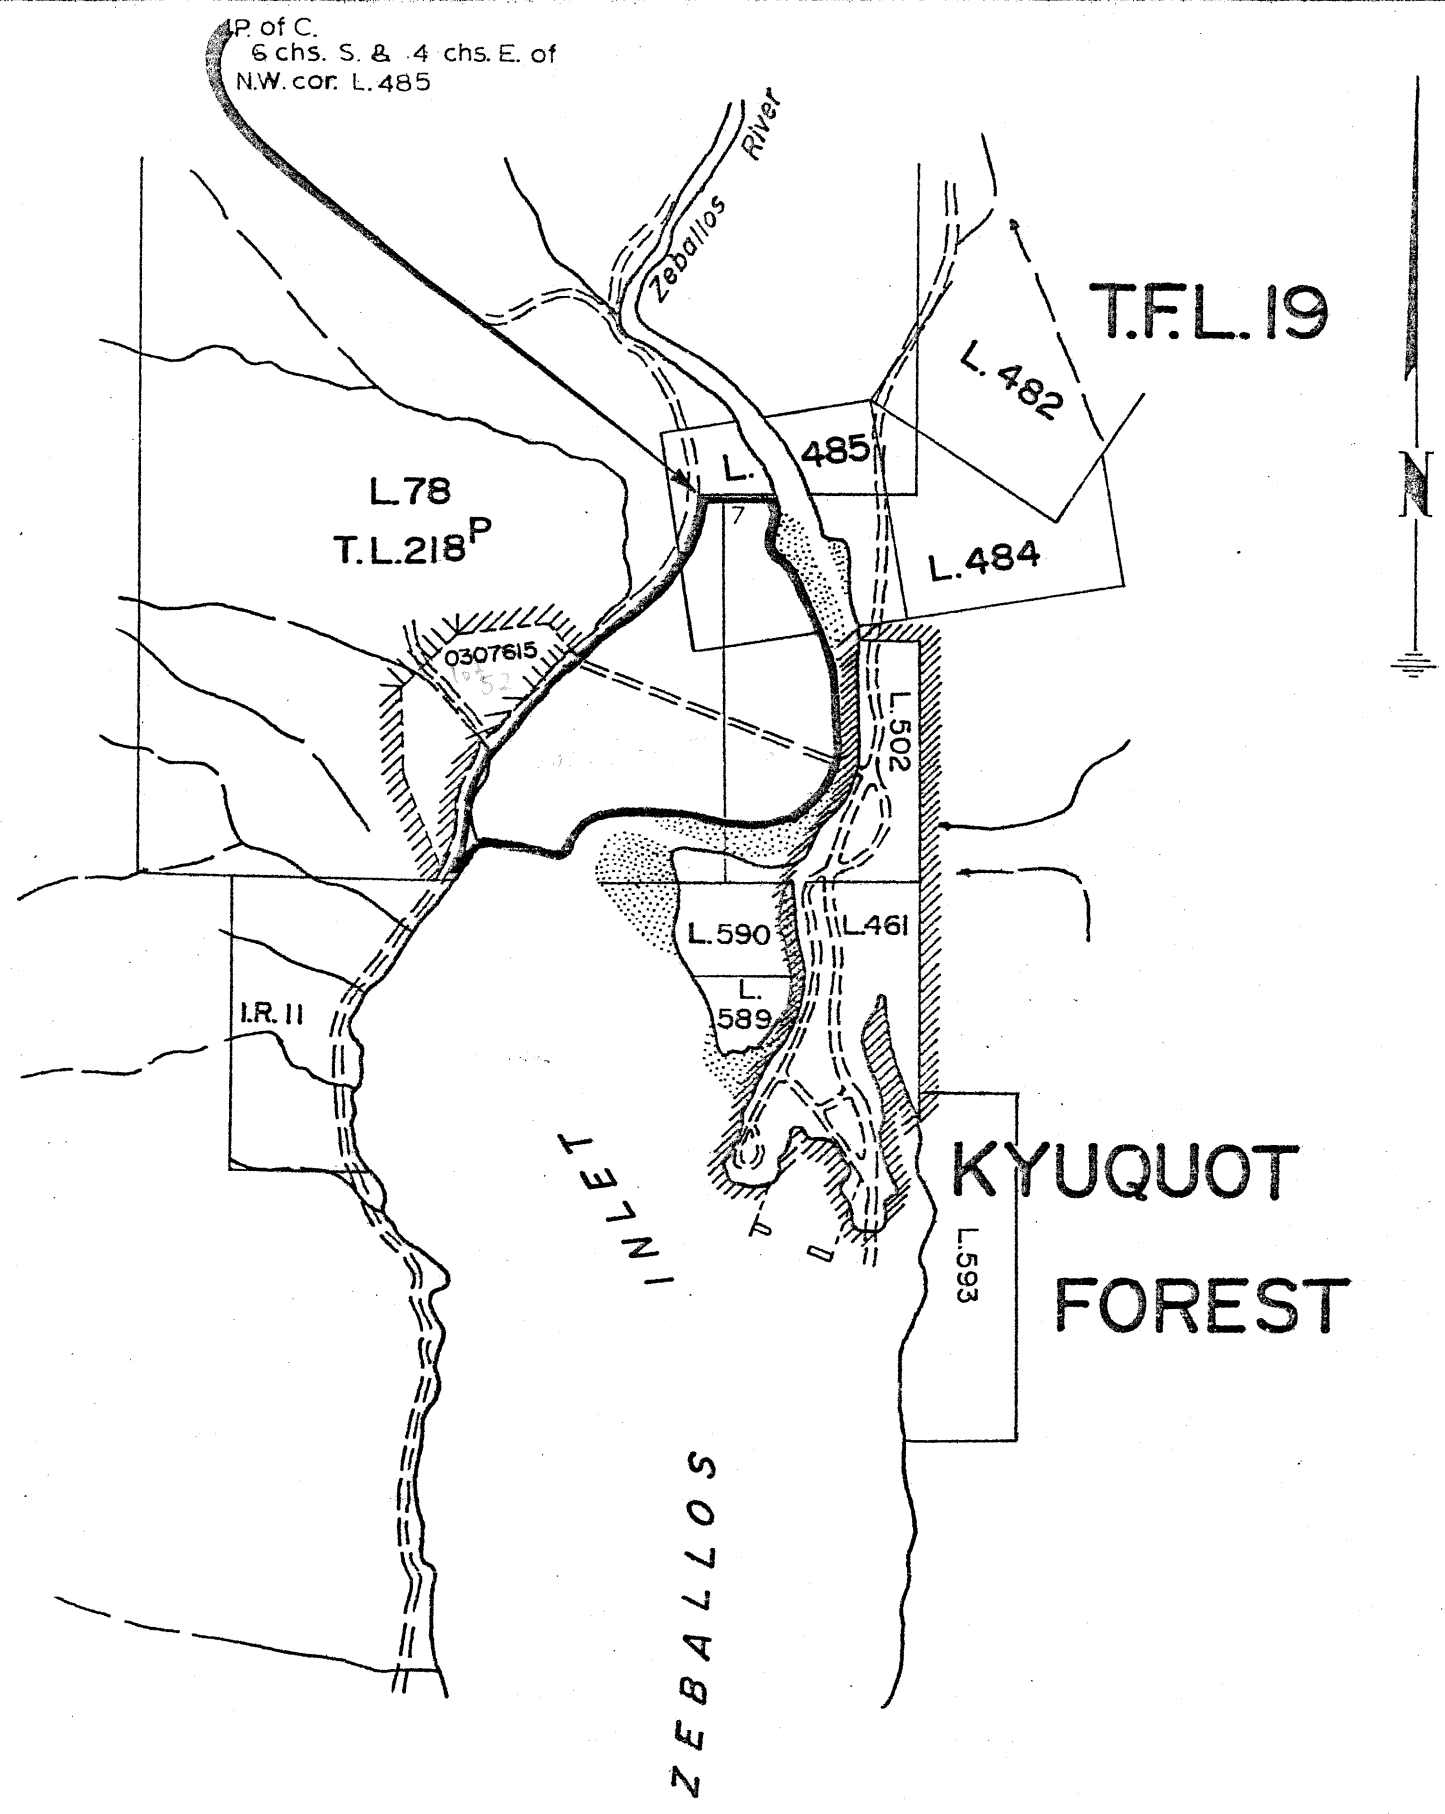

FOREST BOUNDARY..... ///////////////
LOGGING CAMPSITE..... 0307615

Sketch Amended 6/6/75 RW

Drawn by grb