

COPY

93D 028

PROVINCE OF BRITISH COLUMBIA

Department of Lands, Forests, and Water Resources

FOREST SERVICE

IN THE MATTER OF TREE FARM LICENCE NUMBER 23

AMENDMENT NUMBER 74

Whereas by a notice in writing under my hand dated the 9th day of November, 1966 and designated Amendment Number 71 in the matter of Tree Farm Licence Number 23 certain lands were withdrawn from Schedule "B" of the said Tree Farm Licence for the purpose of a passive reflector site;


And whereas an error occurred in such amendment;

Therefore the said Amendment Number 71 is hereby cancelled and pursuant to Subsection (14) of Section 36 of the Forest Act being Chapter 153 of the Revised Statutes of British Columbia 1960 and pursuant to Clause 10 of the said Tree Farm Licence Number 23 the following lands are hereby withdrawn from the lands described in Schedule "B" of the said Tree Farm Licence that is to say shown on the sketch attached hereto and described as follows:

"That part of Kootenay Land District comprising a square with sides one hundred feet (100') long lying in cardinal directions, the centre of said square being at Latitude 52° 01' 07" N. and Longitude 118° 32' 55" W., and containing 23/100 acre, more or less.


and the said lands so withdrawn are and shall be no longer subject to or form any part of the said Tree Farm Licence.


Dated at the City of Victoria in the Province of British Columbia this . . . 13th day of . FEBRUARY 1967.

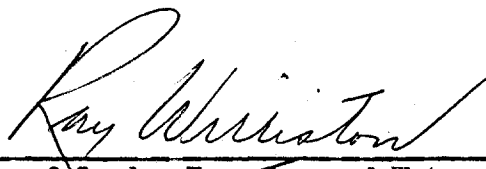

Minister of Lands, Forests, and Water Resources

THB 1-49 IB 50-70 SP 71-126 9009
*** Beginning Plot: C:\SPL\PIC_PLT.01
*** Start Time: Sat Mar 14 14:24:34 1992
*** Total Time: 0: 0:12

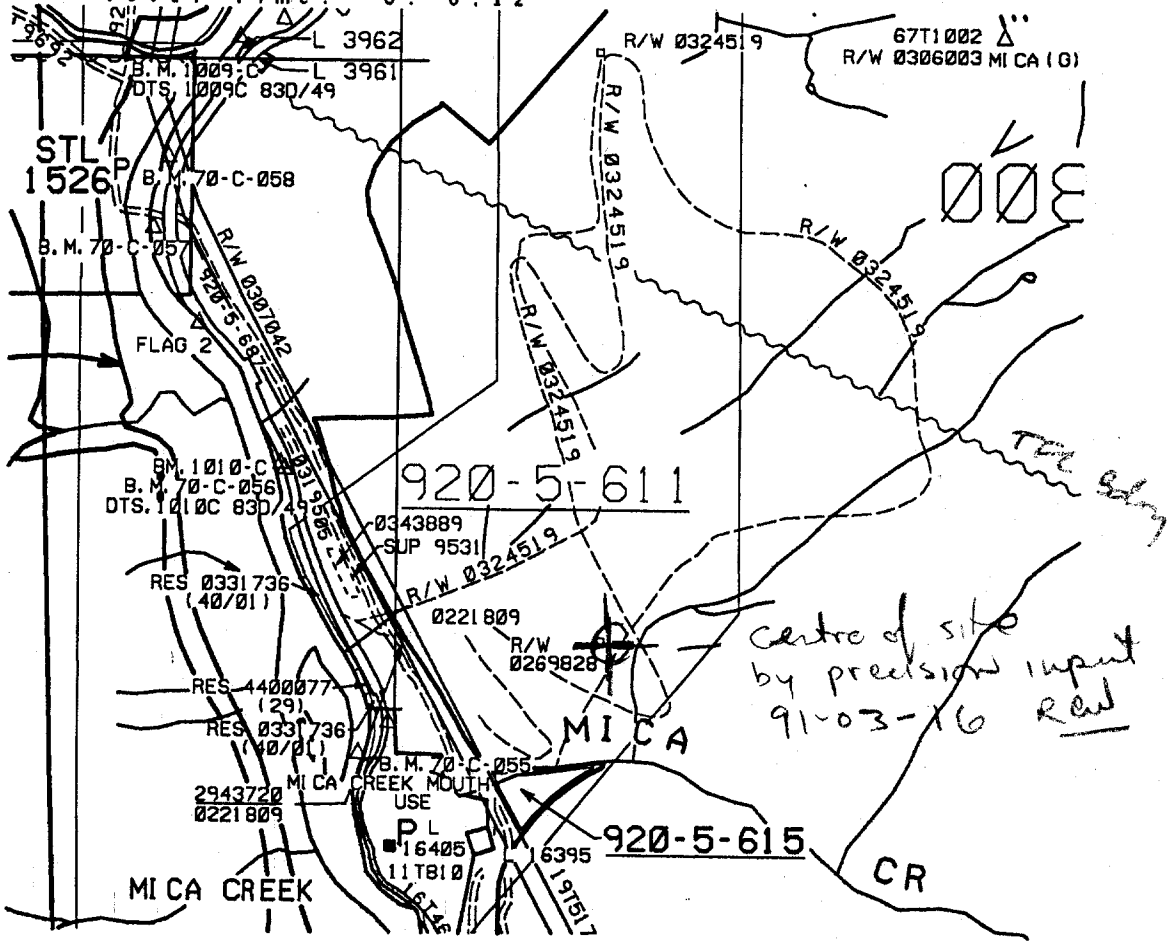

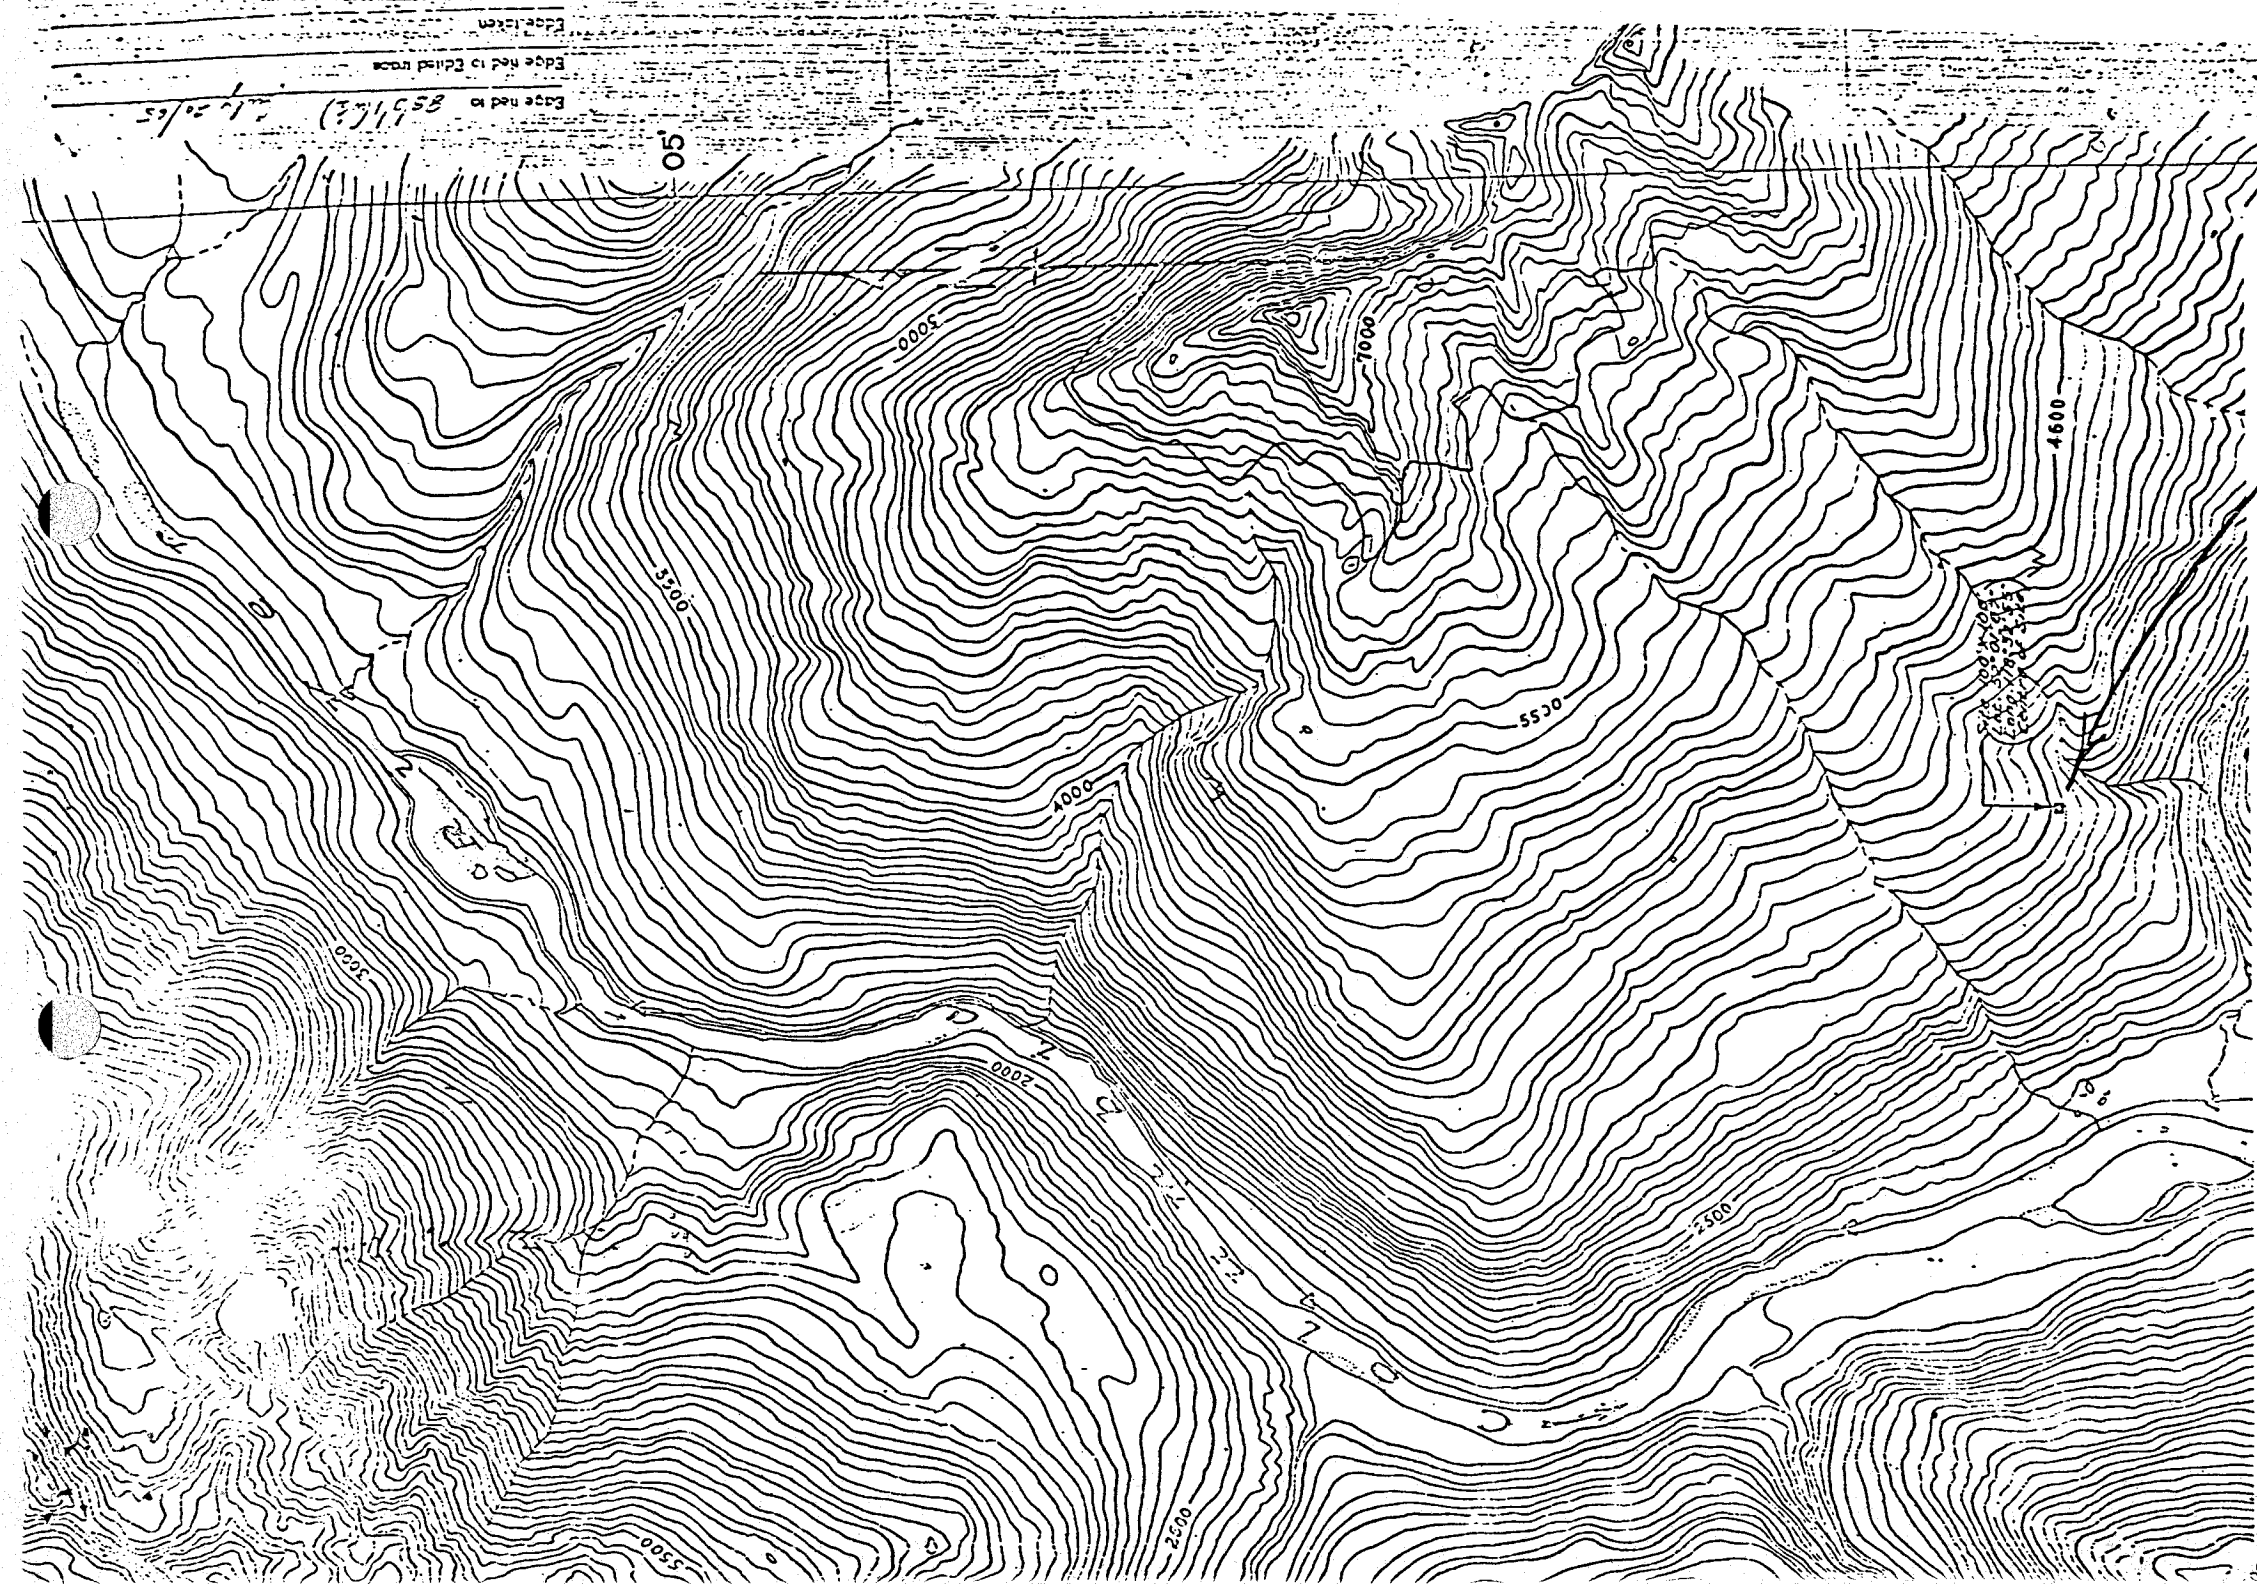

Edge tied to Edited track

Edge tied to 8551(43)

T. F. L. 23 - AMENDMENT No 74

Passive Reflector Site, Okanagan Tel. Co.

Map 8551/2-E
Compiled 1965 Photos Spartan 1951

Advance Information
Subject to Revision

Consent may be obtained from the Map Distributor,
Office, Department of Mines and Technical Surveys,
Ottawa.

Scale 1:40,000

52°00'
118°30'

Red Jan 3/6