

COPY

PROVINCE OF BRITISH COLUMBIA
Department of Lands, Forests, and Water Resources
FOREST SERVICE

IN THE MATTER OF TREE FARM LICENCE NUMBER 30
AMENDMENT NUMBER 5

Whereas notice has been received from Sinclair Spruce Lumber Company Limited, Licensee of Tree Farm Licence Number 30, that it has acquired title to the following lands:

"N.W.¼ of Lot 2711 containing 160 acres,
S.E.¼ of Lot 2713 containing 160 acres,
S.E.¼ of S.W.¼ of Lot 1814 containing
40 acres, Cariboo Land District."


And whereas the said lands showed outlined in red on the attached sketch are situated within the boundaries of the licence area;

Therefore pursuant to subsection (9) of Section 36 of the *Forest Act* being Chapter 153 of the Revised Statutes of British Columbia 1960 and pursuant to Clause 7 of the said Tree Farm Licence Number 30, the lands described above are hereby incorporated in Schedule "A" of the said Tree Farm Licence Number 30 and the said lands so incorporated are and shall be henceforth part of and subject to the said Tree Farm Licence Number 30.

Dated at the City of Victoria in the Province of British Columbia
this . . . 18th . . . day of . NOVEMBER . . . , 1969.



Minister of Lands, Forests, and Water Resources

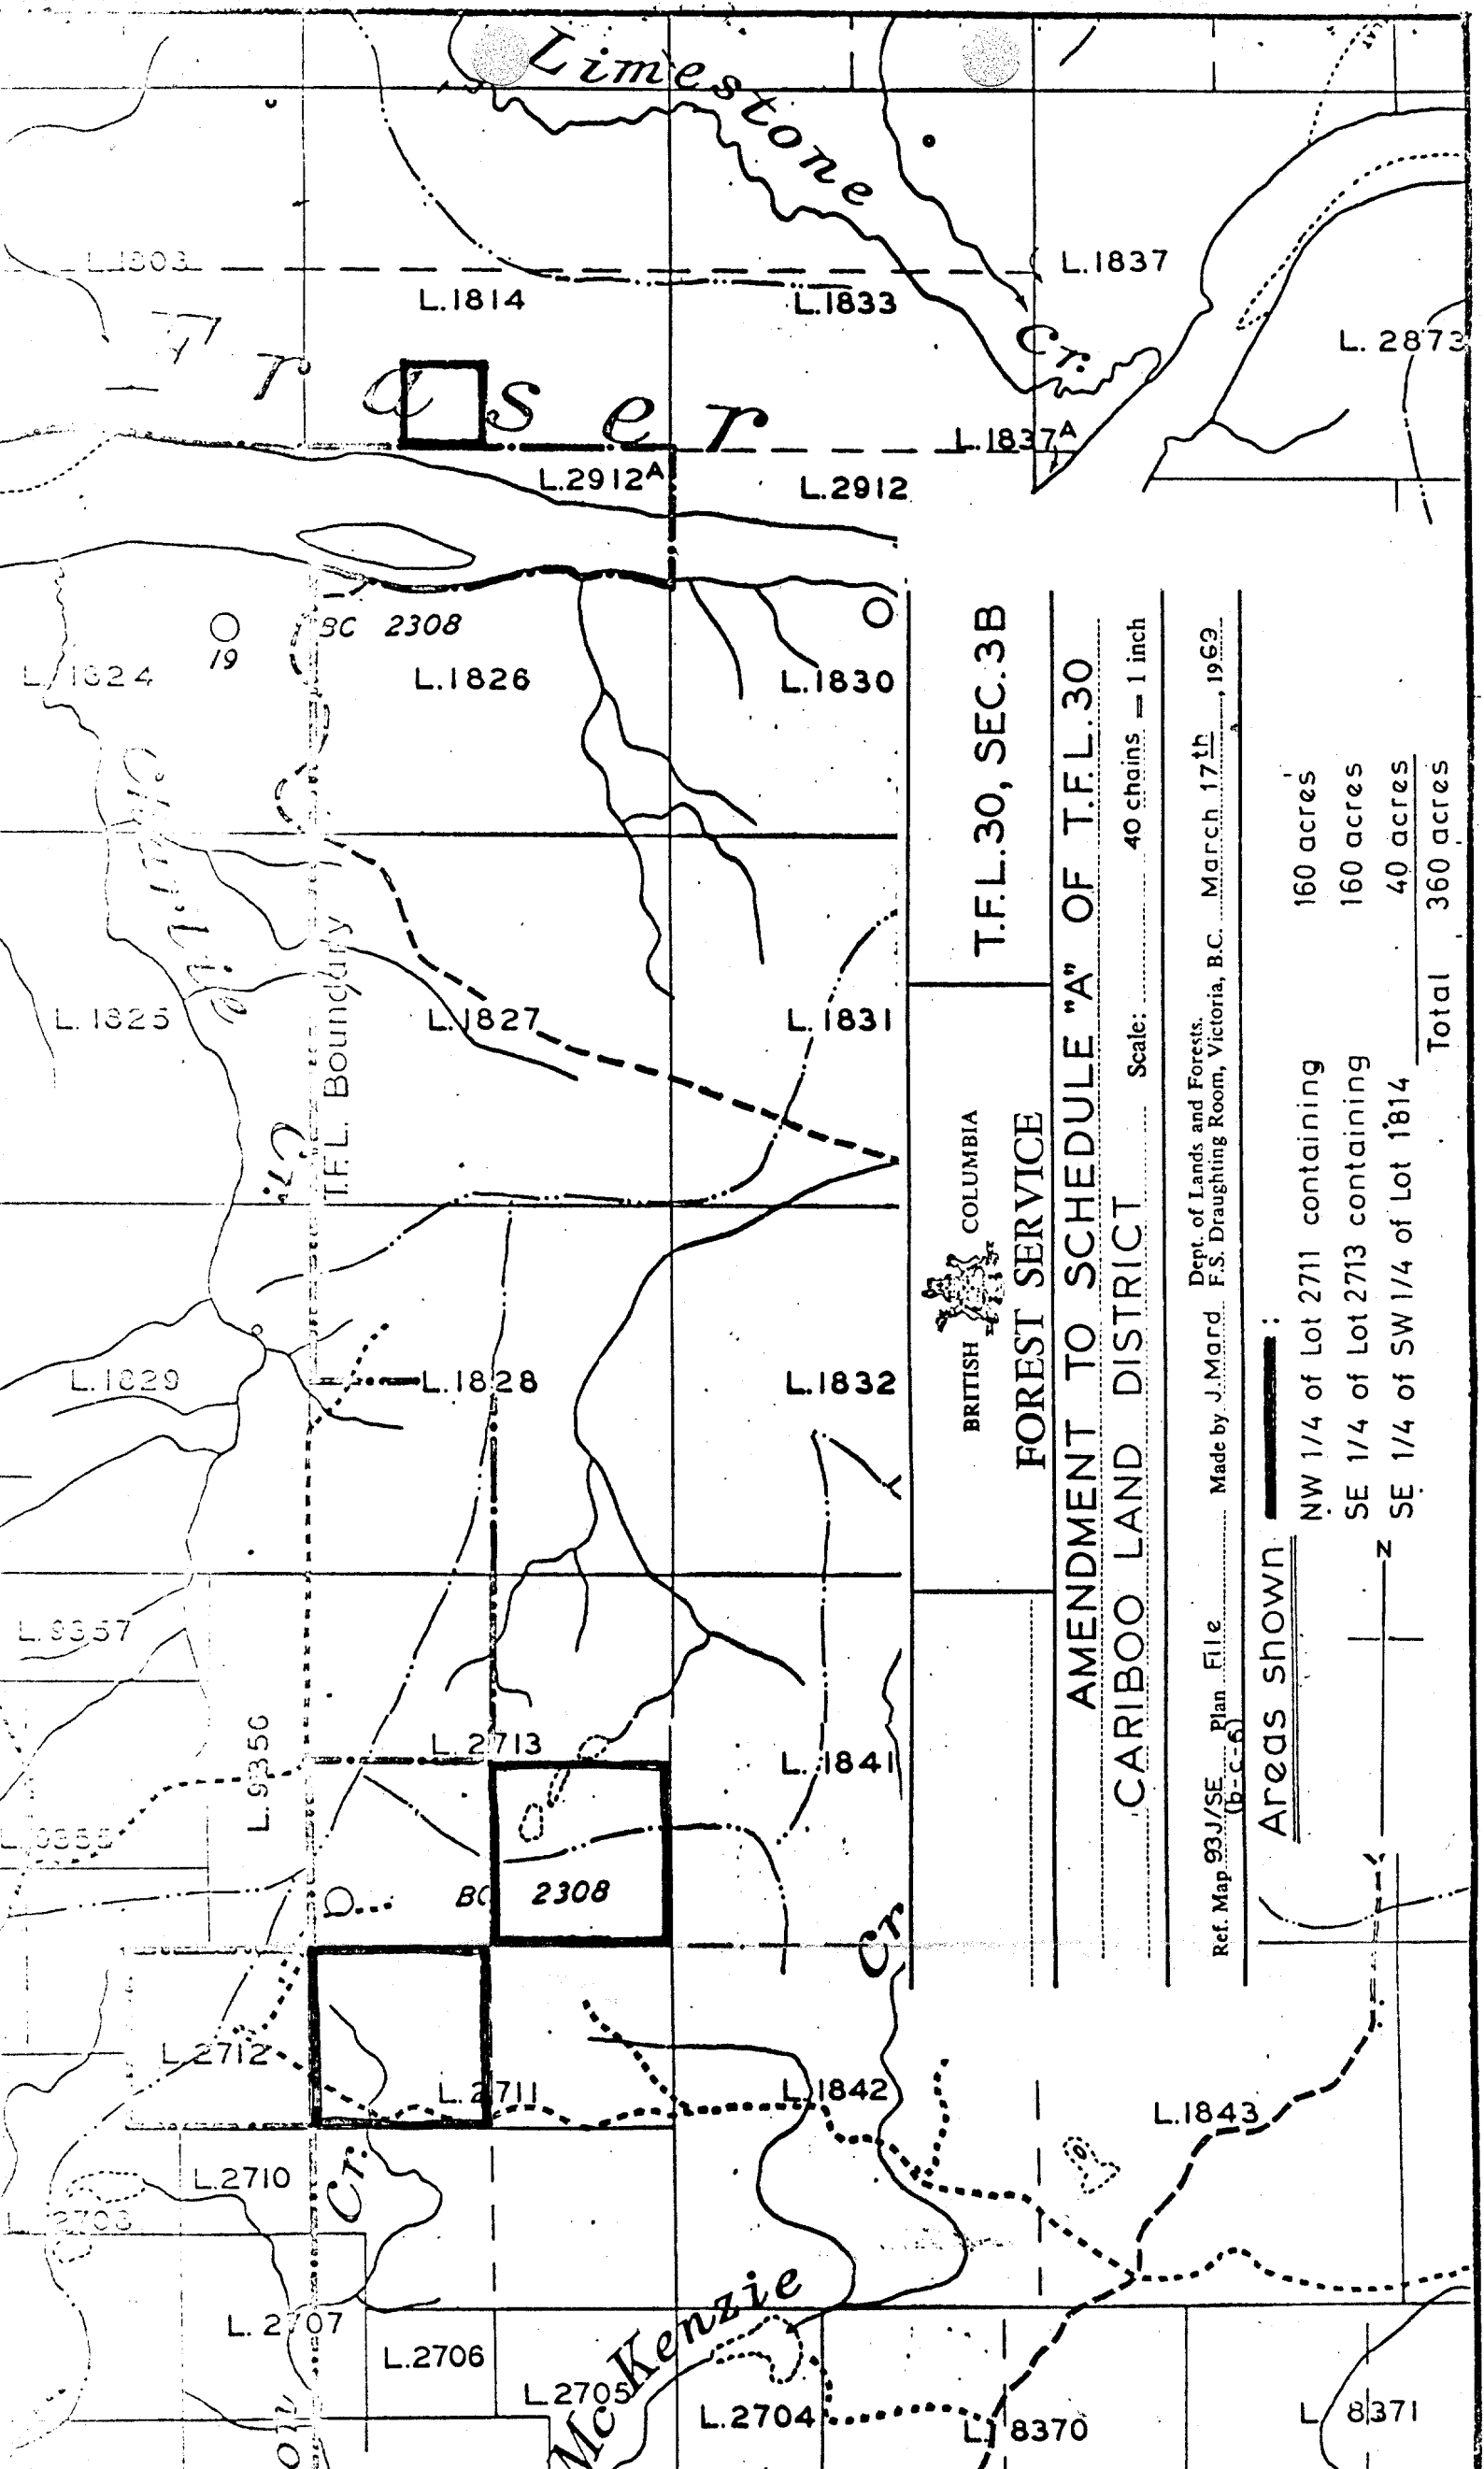

T.F.L. 30, SEC. 3B

BRITISH COLUMBIA

 FOREST SERVICE

AMENDMENT TO SCHEDULE "A" OF T.F.L. 30
 CARIBOO LAND DISTRICT

Scale: 40 chains = 1 inch

Ref. Map 93J/SE Plan File (b-c-6) Made by J. Mard F.S. Draughting Room, Victoria, B.C. March 17th, 1969

AREAS SHOWN

| | |
|-------------------------------|------------------|
| NW 1/4 of Lot 2711 containing | 160 acres |
| SE 1/4 of Lot 2713 containing | 160 acres |
| SE 1/4 of SW 1/4 of Lot 1814 | 40 acres |
| Total | 360 acres |