

PROVINCE OF BRITISH COLUMBIA

Department of Lands, Forests, and Water Resources

FOREST SERVICE

IN THE MATTER OF TREE FARM LICENCE NUMBER 39

AMENDMENT NUMBER 56

Whereas by a notice in writing under my hand dated the 21st day of January, 1965 and designated Amendment Number 50 in the matter of Tree Farm Licence Number 39 certain lands were withdrawn from Schedule "B" of the said Tree Farm Licence for the purpose of a right-of-way for the removal of forest products;

And whereas the logging road is located in a different location than as described in the said Amendment Number 50;

Therefore the said Amendment Number 50 is hereby cancelled and pursuant to Clause 12 of the said Tree Farm Licence, the following lands are herewith withdrawn from the lands described in Schedule "B" of the said Tree Farm Licence for the purpose of a right-of-way under Part VI of the Forest Act for the period necessary for the removal of forest products from Timber Sale X84123 and Timber Leases 1840P and 2793P or any extension or resale thereof:

"The logging right-of-way, 40 feet in width, situated north of Goat Lake in New Westminster Land District, as shown in bold black on the sketch attached hereto."

and the lands so withdrawn are and shall be henceforth no longer part of or subject to the said Tree Farm Licence Number 39 during the duration of amended Special Use Permit Number 2855.

Dated at the City of Victoria in the Province of British Columbia this 11th day of July, 1966.


Minister of Lands, Forests, and Water Resources

MAP OF S.U.P. 2855

Situated north of Goat Lake
LAND DISTRICT NEW WESTMINSTER


AMENDMENT NO. 56

T.F.L. NO. 39

X 84123
Blk. 1.

S.T.L. 1485^P

S.T.L. 1840^P

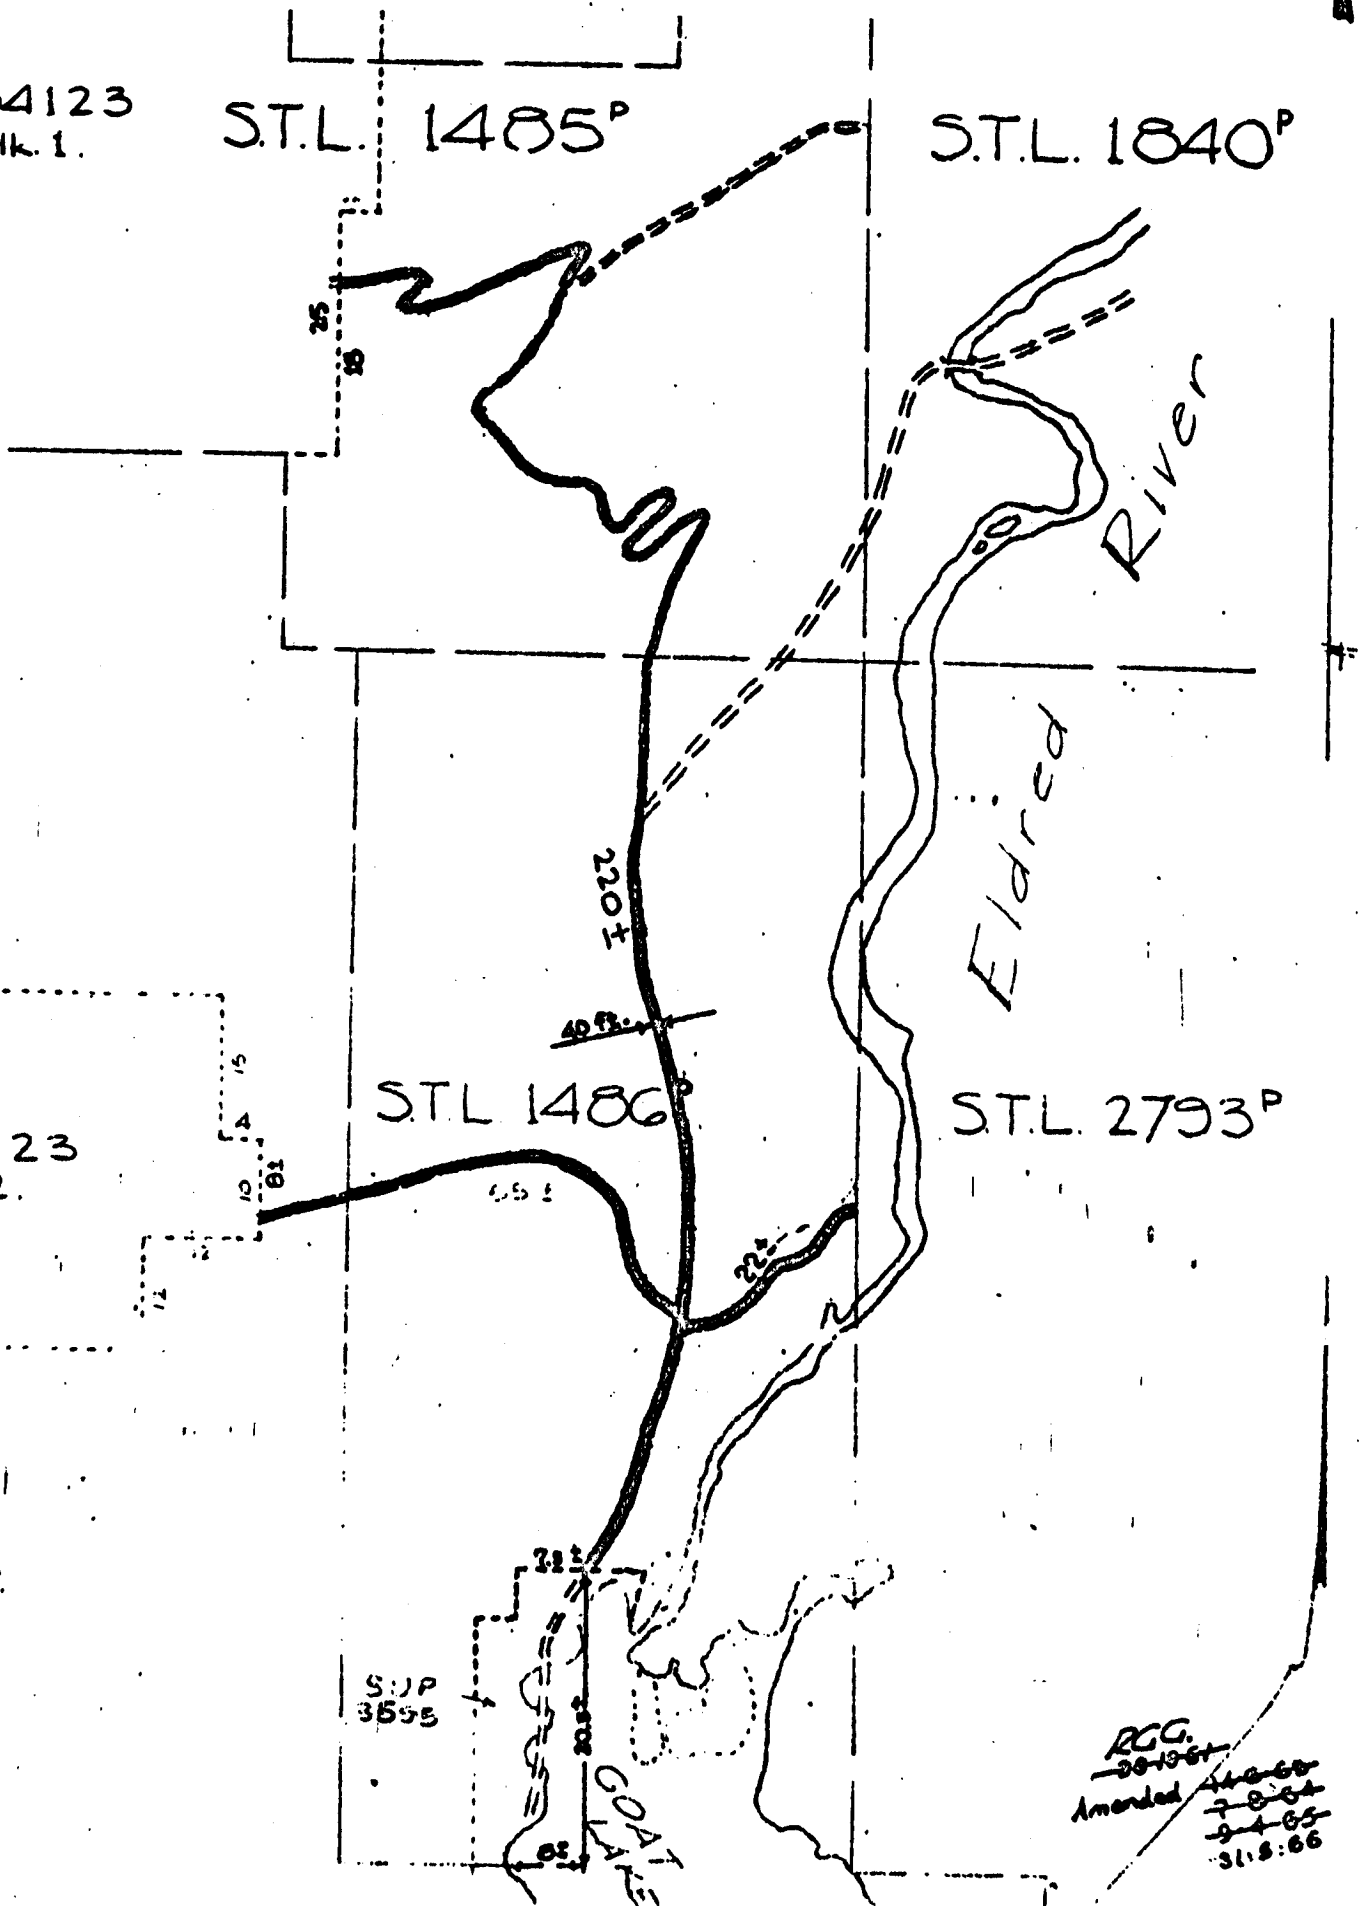

X 84123
Blk. 2.

S.T.L. 1486^P

S.T.L. 2793^P

SUP
3555

GOAT
LAKE

RCG.
28-1964
Amended 4-26-65
7-8-65
9-4-65
31.8.66

MEMORANDUM TO THE HONOURABLE THE MINISTER

Attached in duplicate is Amendment Number 56 to Tree Farm Licence Number 39 - which cancels Amendment Number 50 and redescibes area withdrawn during the term of S.U.P. 2855 from Schedule "B" of the Licence for a 40 foot logging right-of-way.

Your signature is recommended.



L. F. Swannell,
Chief Forester.