

PROVINCE OF BRITISH COLUMBIA

Department of Lands, Forests, and Water Resources

FOREST SERVICE

IN THE MATTER OF TREE FARM LICENCE NUMBER 39

AMENDMENT NUMBER 64


Whereas notice has been received from MacMillan Bloedel Limited, Licensee of Tree Farm Licence Number 39, that it has acquired title to the following lands:


"D.L. 4716, Group 1, New Westminster District; being more particularly shown outlined in red on the sketch attached hereto. Certificate of Title Number 519762-L. Acreage - 80 acres. Reported Volume - Nil."

And whereas the said lands are situated within the boundaries of the licence area;

Therefore pursuant to Subsection (9) of Section 36 of the Forest Act being Chapter 153 of the Revised Statutes of British Columbia, 1960, and pursuant to Clause 8 of the said Tree Farm Licence Number 39, the lands described above are hereby incorporated in Block 1 of Schedule "A" of the said Tree Farm Licence Number 39 and the said lands so incorporated are and shall be henceforth part of and subject to the said Tree Farm Licence Number 39.

Dated at the City of Victoria in the Province of British Columbia this14th..... day of ...SEPTEMBER....., 1966.

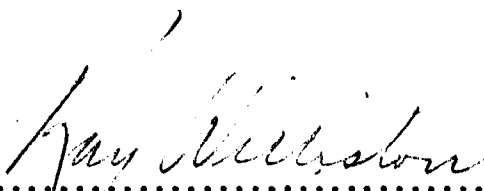

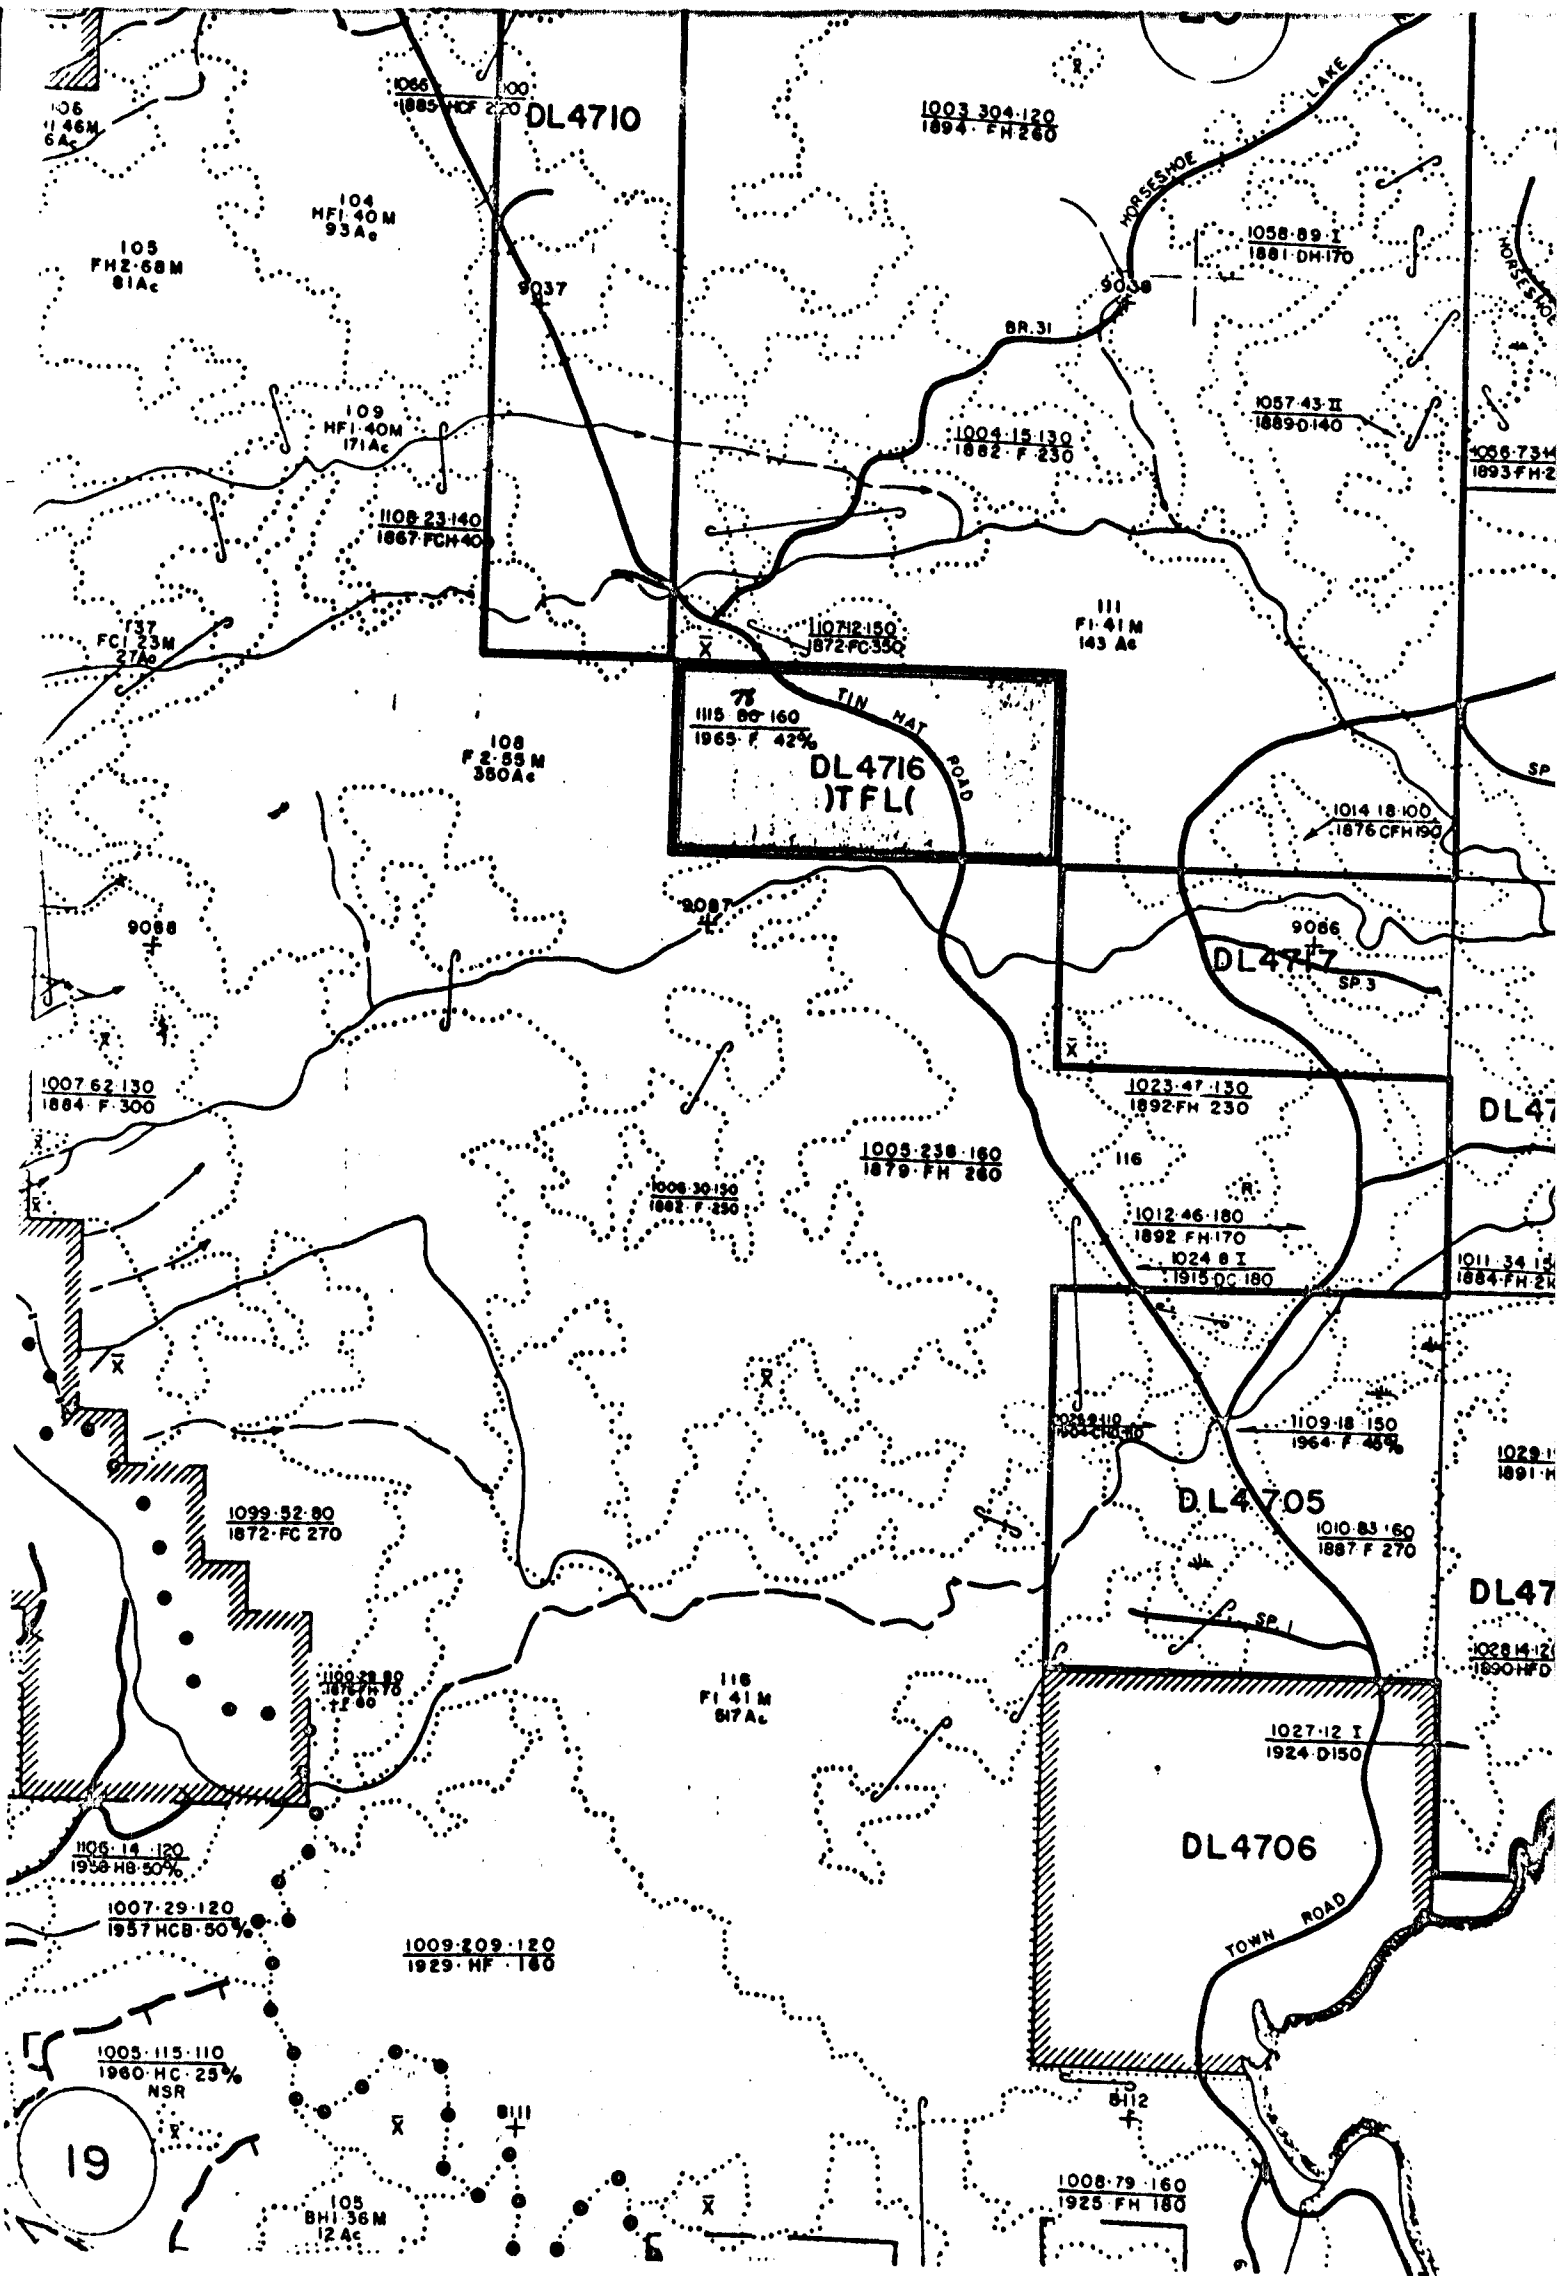.....
Minister of Lands, Forests, and Water Resources



AMENDMENT NO. 64
T.F.L. NO. 39

Attached in duplicate is Amendment No. 64 to
T.F.L. 39 - MacMillan Bloedel Limited - which adds
D.L. 4716, Group 1, New Westminster District to
Schedule "A" of the licence.

Your signature is recommended.


L.F. Swannell,
Chief Forester.