

COPY

PROVINCE OF BRITISH COLUMBIA

Ministry of Forests

---

IN THE MATTER OF TREE FARM LICENCE NUMBER 47

INSTRUMENT NUMBER 6

AMENDMENT

---


WHEREAS the lands described hereinafter are within Tree Farm Licence 47 and are found to be suitable for a higher economic use than that of the growing of forest crops;

And whereas the licensee is in agreement with the withdrawal of the aforementioned lands from the Schedule "A" of the said Tree Farm Licence;

Therefore, pursuant to Section 33.1 of the Forest Act, the licensor hereby consents to the withdrawal from Schedule "A" of the said Tree Farm Licence 47, of the following land.

Lot 1433, Range 1, Coast District and the said land so withdrawn shall be henceforth no longer part of or subject to the said Tree Farm Licence Number 47.

Dated at the City of Victoria in the Province of British Columbia this . 27th . . day of February, 1991.

  
Minister of Forests

Attachment



MAP OF **BICKLEY BAY F.S.R. (S.B. P.)**  
**942-8940-00**

**EXHIBIT 'A'**


Province of  
 British Columbia  
 Ministry of  
 Forests and Lands

UTM.	Zone	East			North			Reg	Compt	L
Grd	10	33	03	00	55	90	200	300	13	/

Date ..... 90-05-15 .....  
 Ref. Map ..... 92K/6 .....  
 Base Used ..... FC.(92K044) .....  
 Scale 1: ..... 20000 .....  
 Area ..... hectares ±

FOREST LAND  
 REGION ▶ 01 Vancouver ..... DISTRICT ▶ 10 Coast, Range 1 .....  
 DISTRICT ▶ 18 Campbell River ..... OUTLINE ▶ .....

Type	MANAGEMENT UNIT 0 P.S.Y.U.	Number	TIMBER SUPPLY AREA 37 Strathcona	PULPWOOD AGREEMENT	CASCADES
Number	64 Quadra	Block	12 Loughborough		East
Block		Sub-B			West C

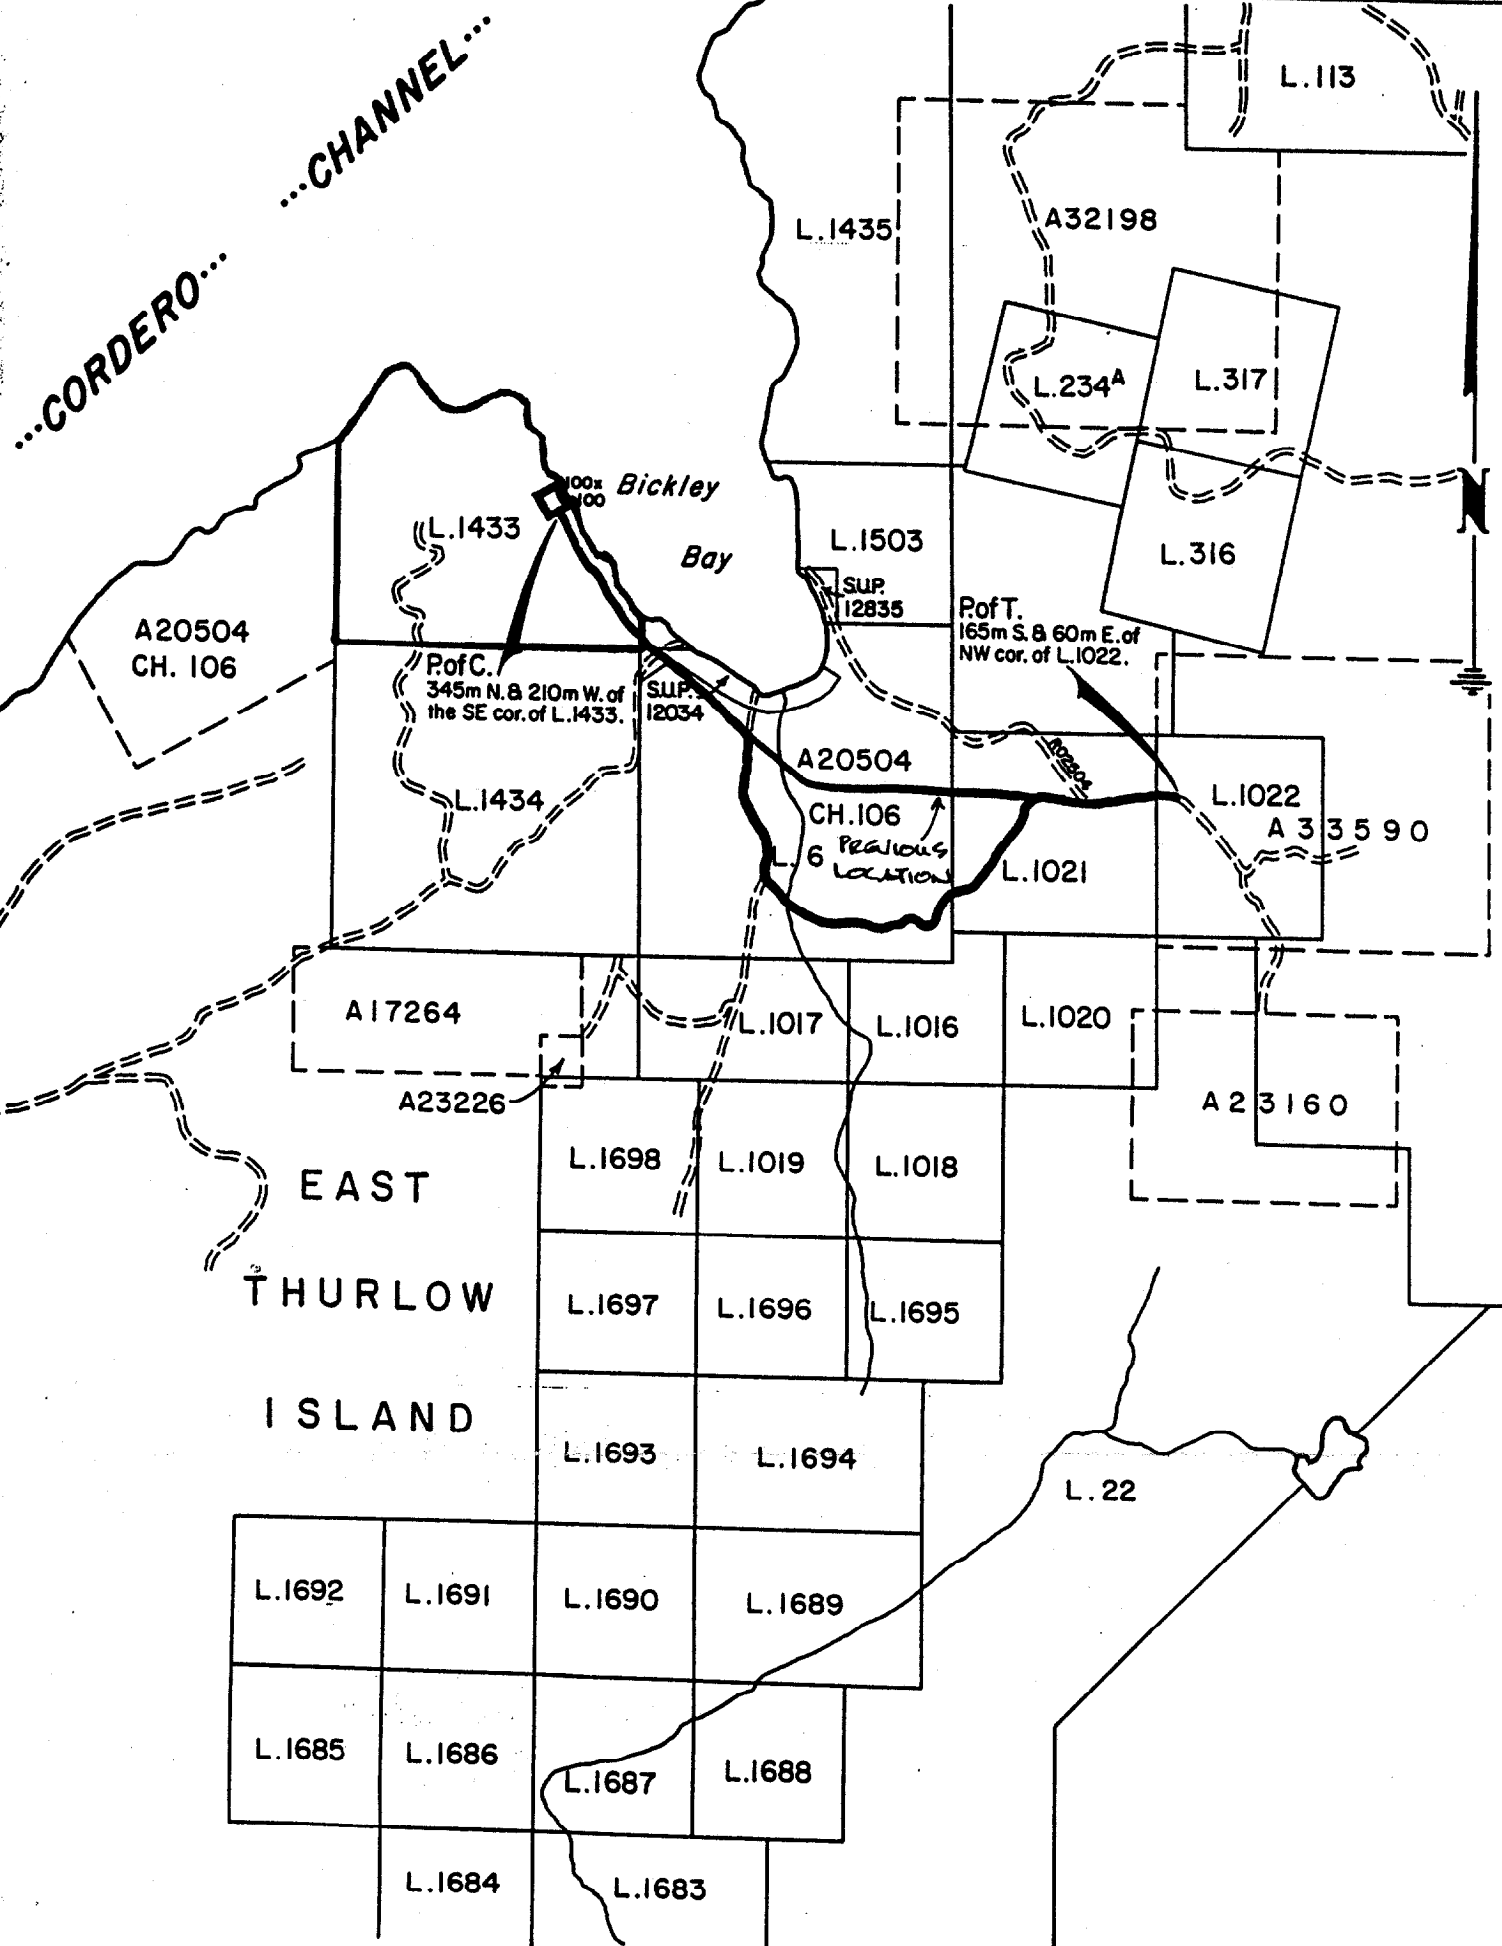

Drawn by C. Loggie