




Ministry of Energy, Mines and Petroleum Resources

Map Confirmation

Placer Legacy Claims

Tenure Number
393522

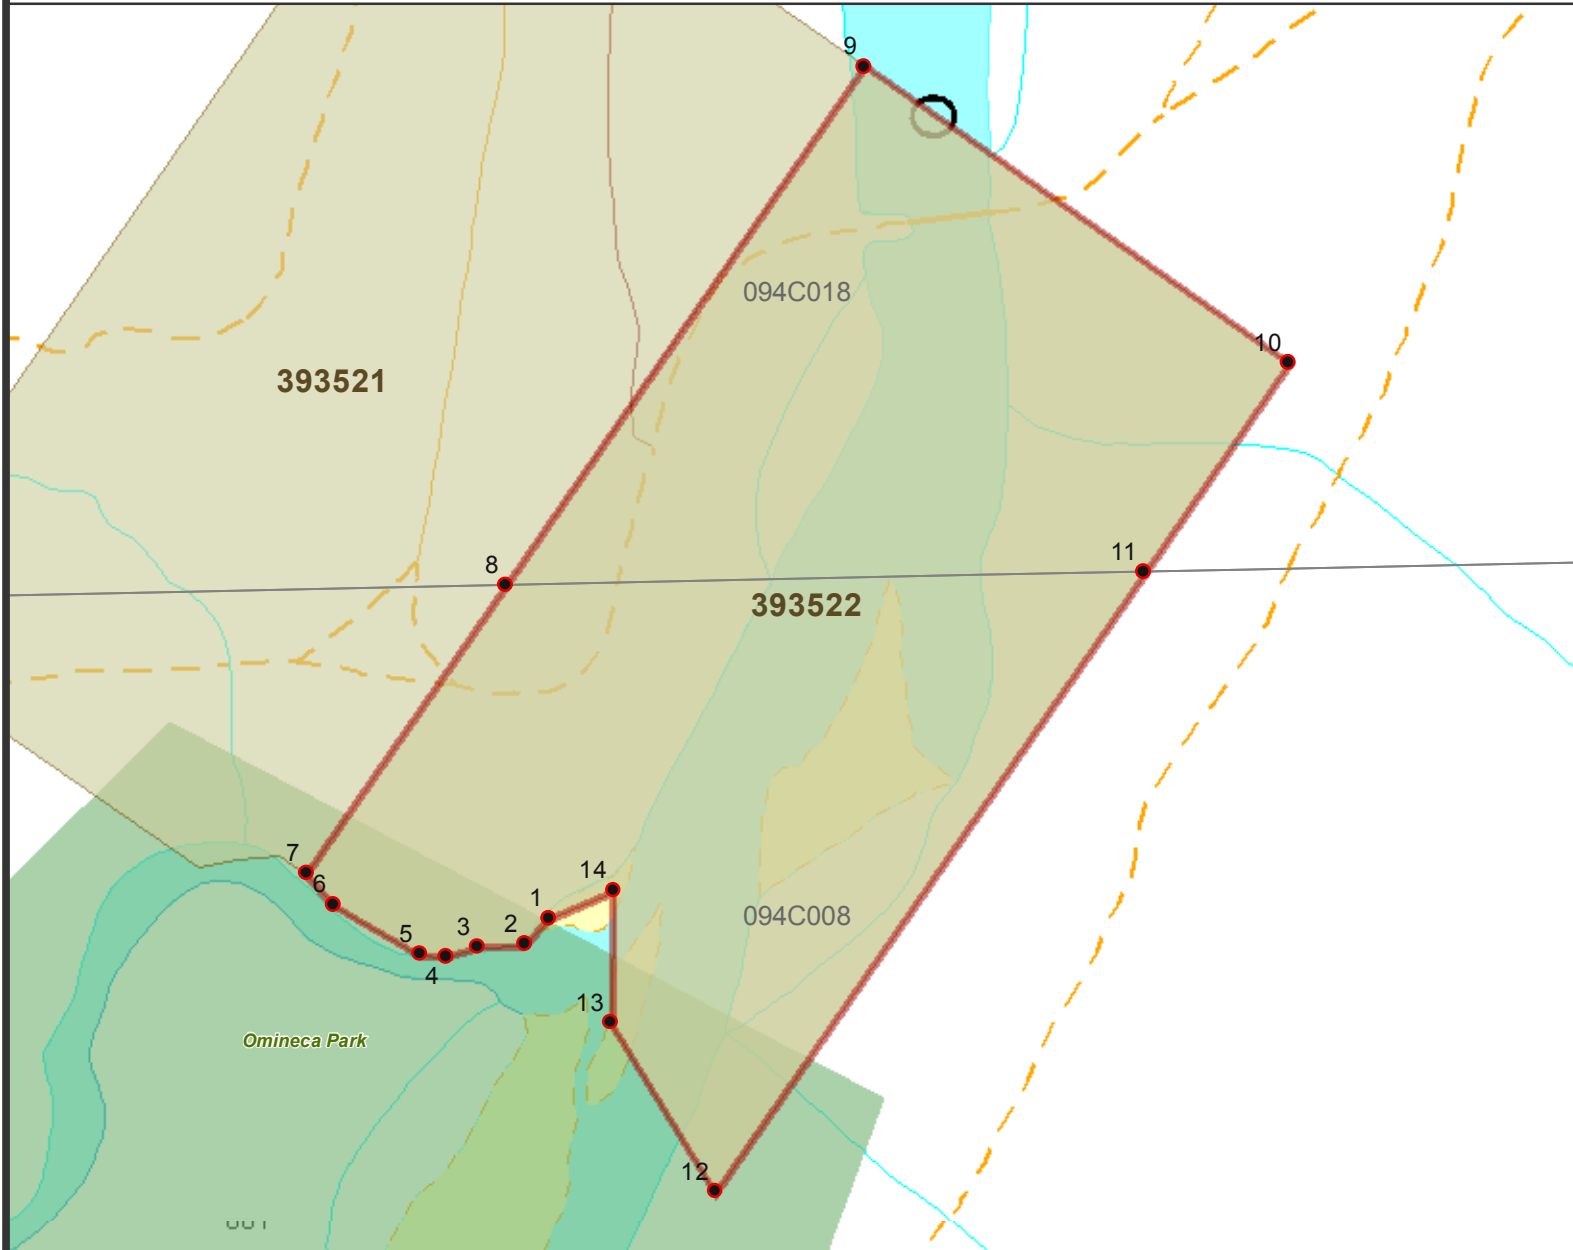

UTM Coordinates [metres]

Point	UTM Zone	Easting	Northing
1	10	405486.177E	6217927.734N
2	10	405461.366E	6217904.295N
3	10	405415.357E	6217903.307N
4	10	405384.736E	6217895.509N
5	10	405359.433E	6217898.924N
6	10	405277.895E	6217950.194N
7	10	405253.193E	6217981.202N
8	10	405457.623E	6218250.316N
9	10	405825.512E	6218734.617N
10	10	406223.662E	6218432.167N
11	10	406075.216E	6218236.746N
12	10	405635.654E	6217658.092N
13	10	405541.048E	6217825.197N
14	10	405549.775E	6217952.148N

Scale: 1:7,300

● Point with UTM Coordinates
 Legacy Claims
 Parks & Protected Areas
 Mapsheet Grid

