



Placer Lease Application Technical Survey Plan

Application Event Number: 5673580

File Number: 13990-02-744

Area in Hectares: 12.96

Tenure Number(s)	Claim Name(s)
309661	TERRY PFEIFFER

UTM Coordinates (meters)

Point	Easting	Northing
1	595532.85	5835464.38
2	595309.86	5835324.57
3	595402.23	5835177.26
4	595791.47	5835036.47
5	595575.48	5834900.98


All Points are within UTM Zone 10

I hereby agree with the boundary as identified in red and the coordinates provided

X

Nuohui Mining Ltd. (280147)

Date:

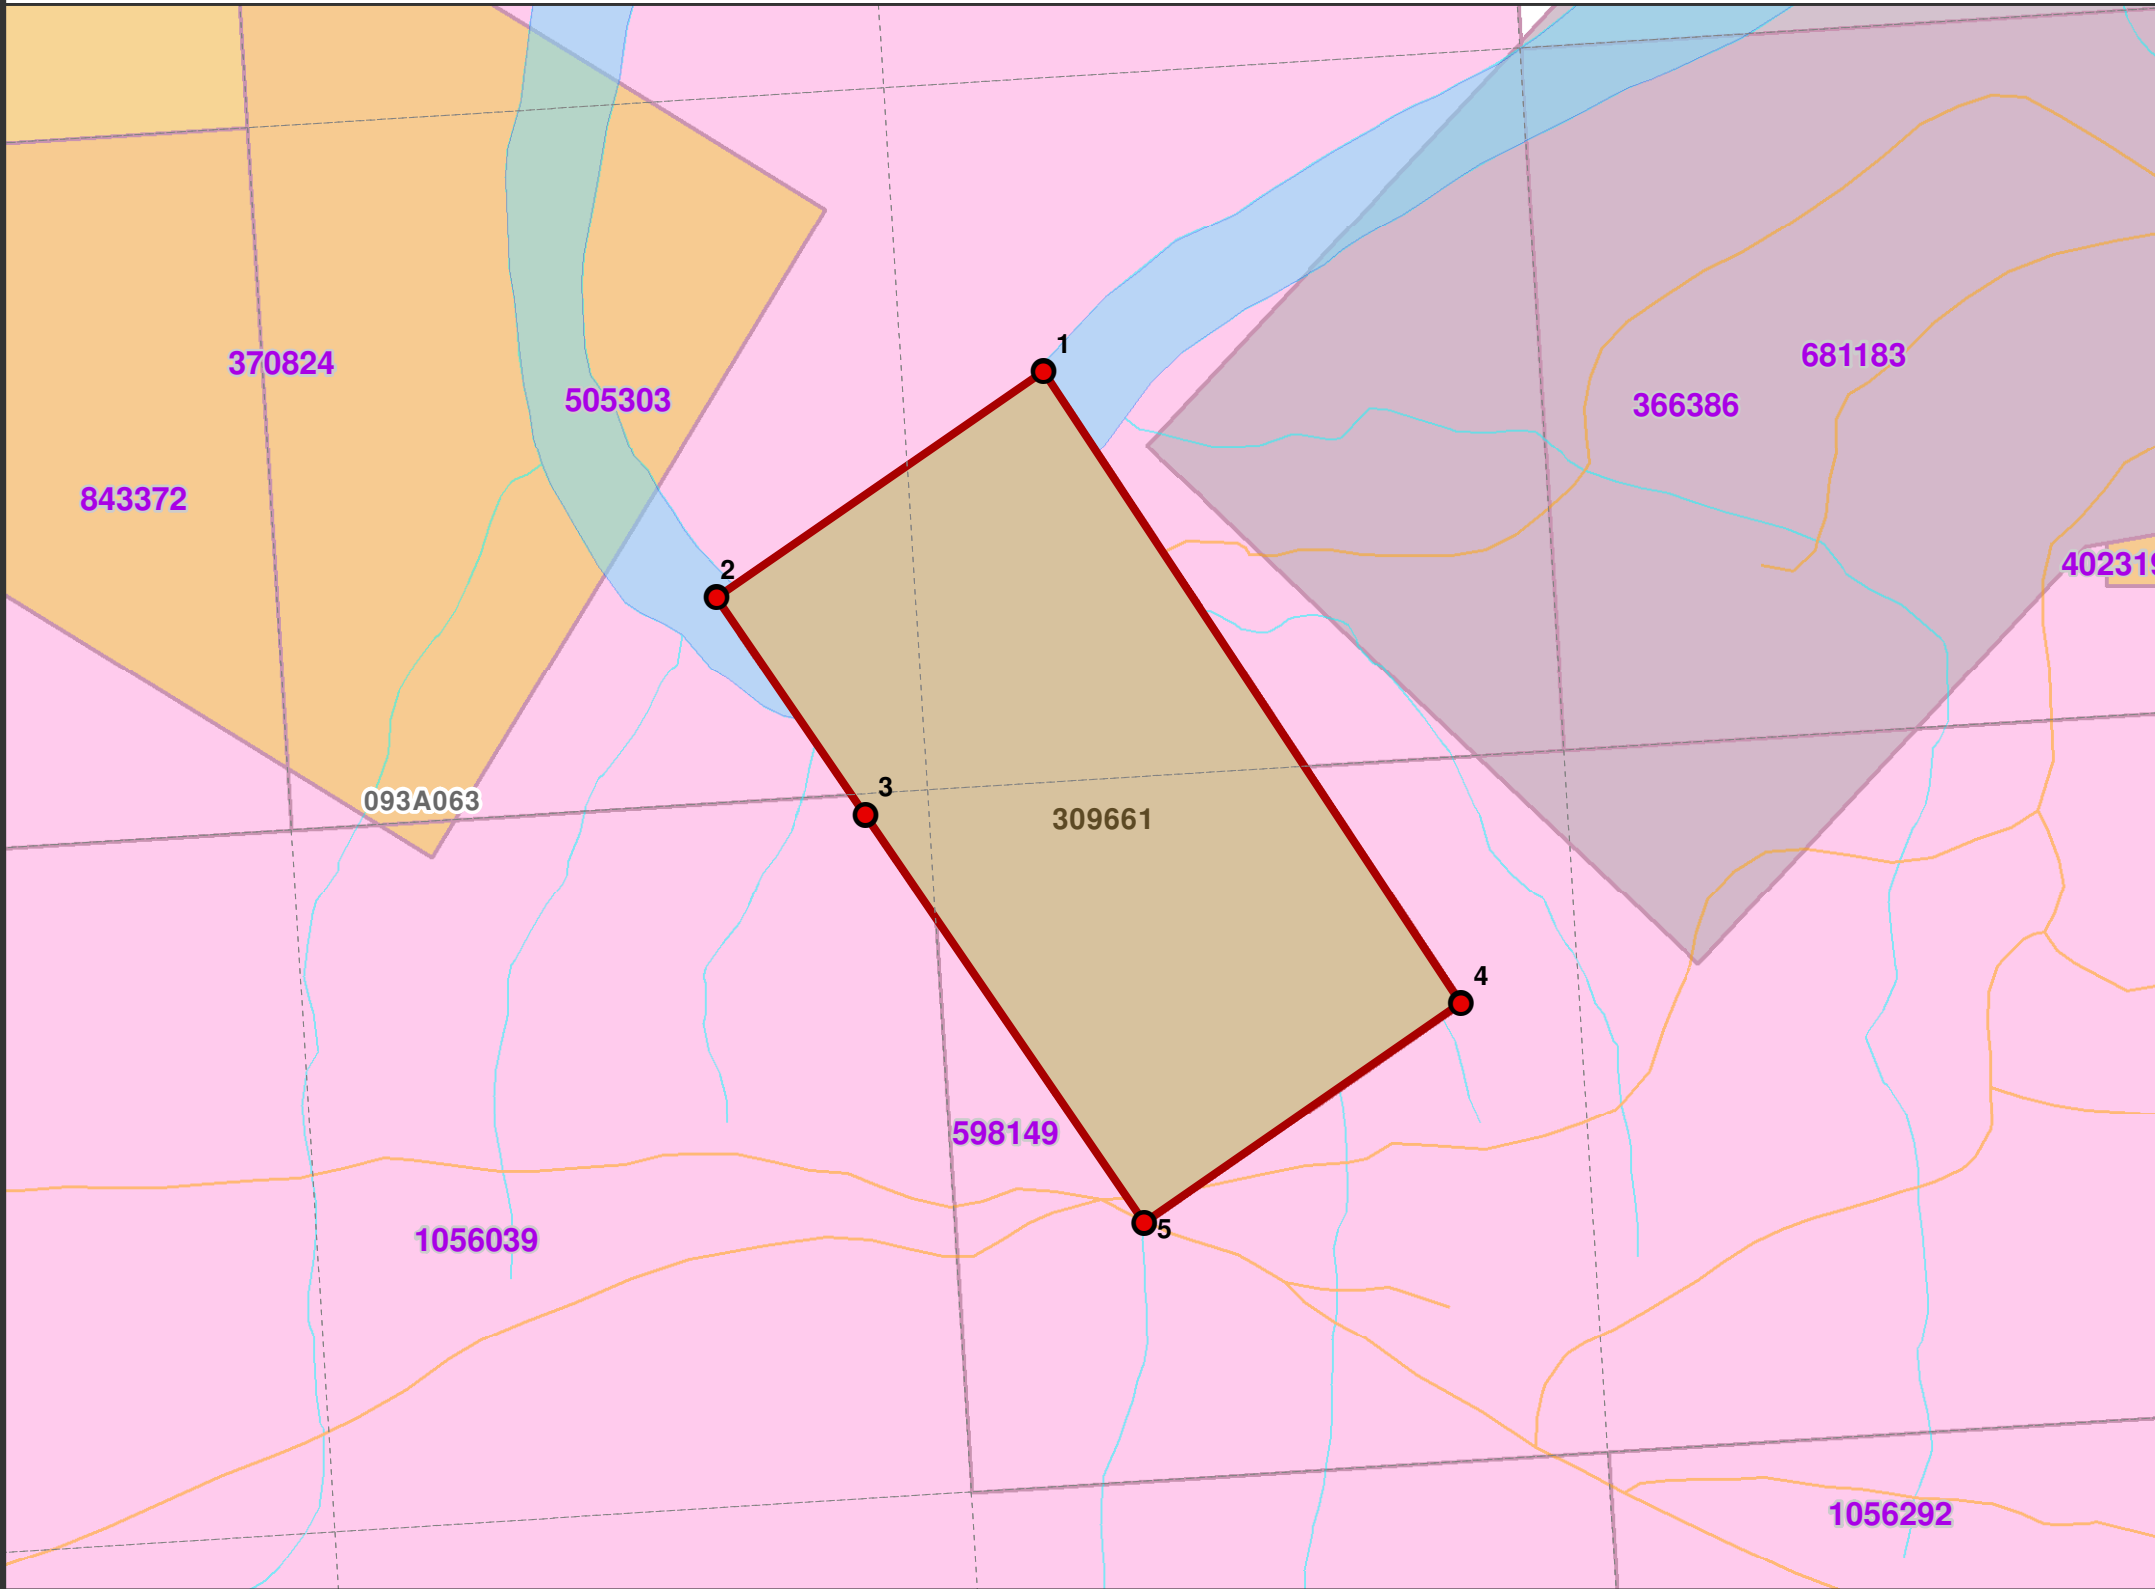

Scale: 1:5,000

● Points with UTM Coordinates
 Placer Lease Boundary
 Placer Leases
 Placer Legacy Titles
 Placer Cell Titles
 MTO Cell Grid
 Mapsheet Grid

