

EXAMINATION
PLAN

BRITISH COLUMBIA LAND SERVICE
SURVEYS AND MAPPING BRANCH
LEGAL SURVEYS DIVISION

0284030
0164-314
52033
Victoria File
Request No.
93 M/SW (E2)
Reference Map

Description of Area


Was portions of
Lots 294 425 and 457 (Subj. 577)

Location Kispiox River North of Dobe Creek

CASSIAR Land District
OMINECA Assessment District

PRINCE RUPERT Land Registration District
(Land Inspection District
Ranger District)

Scale: 20 chains = 1 inch

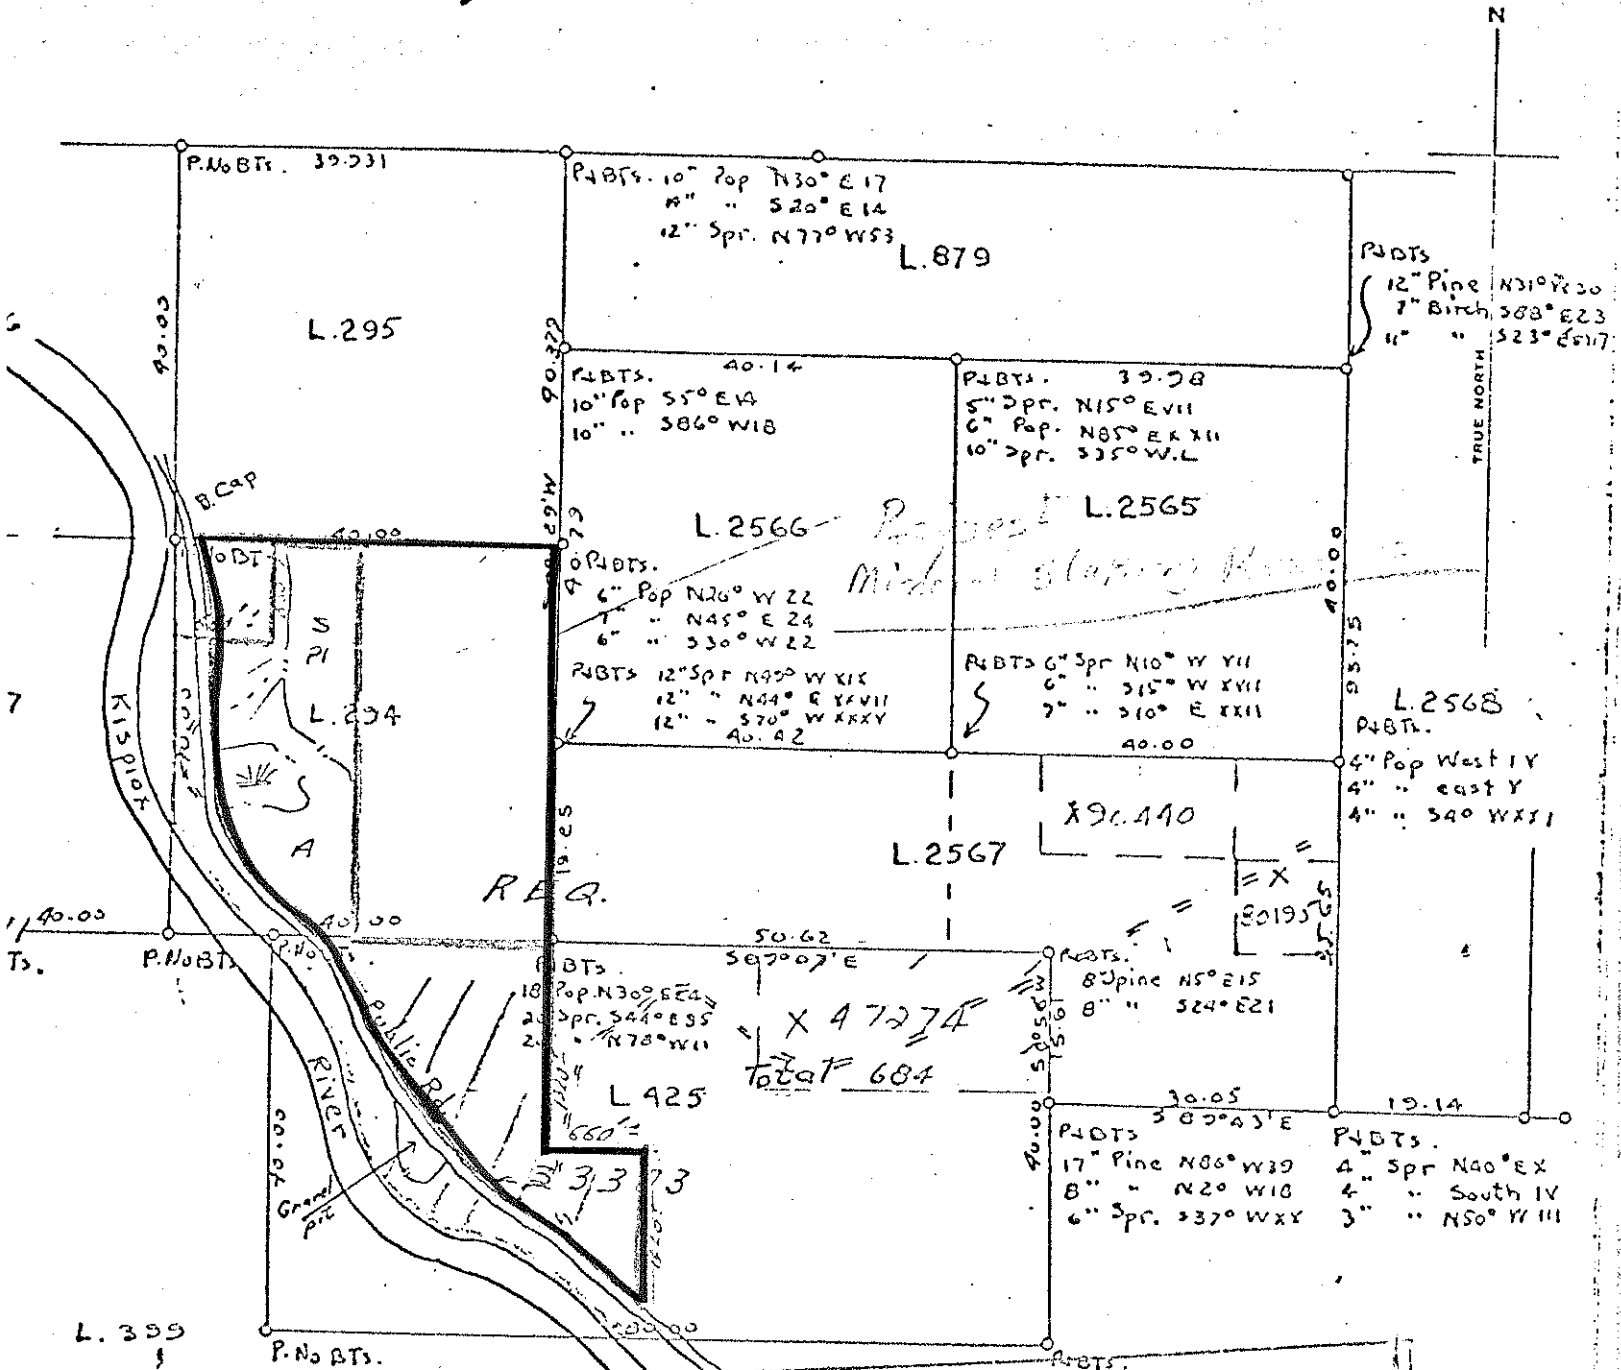

DO NOT REMOVE FROM
FILE. THIS IS PART OF
LETTER INWARD

DO NOT REMOVE FROM
FILE. THIS IS PART OF
LETTER OUTWARD

DATED Jan 2, 1969
FILE NO. 2044/16

MAY 9 1969


Made by [Signature] Date 12/6/64