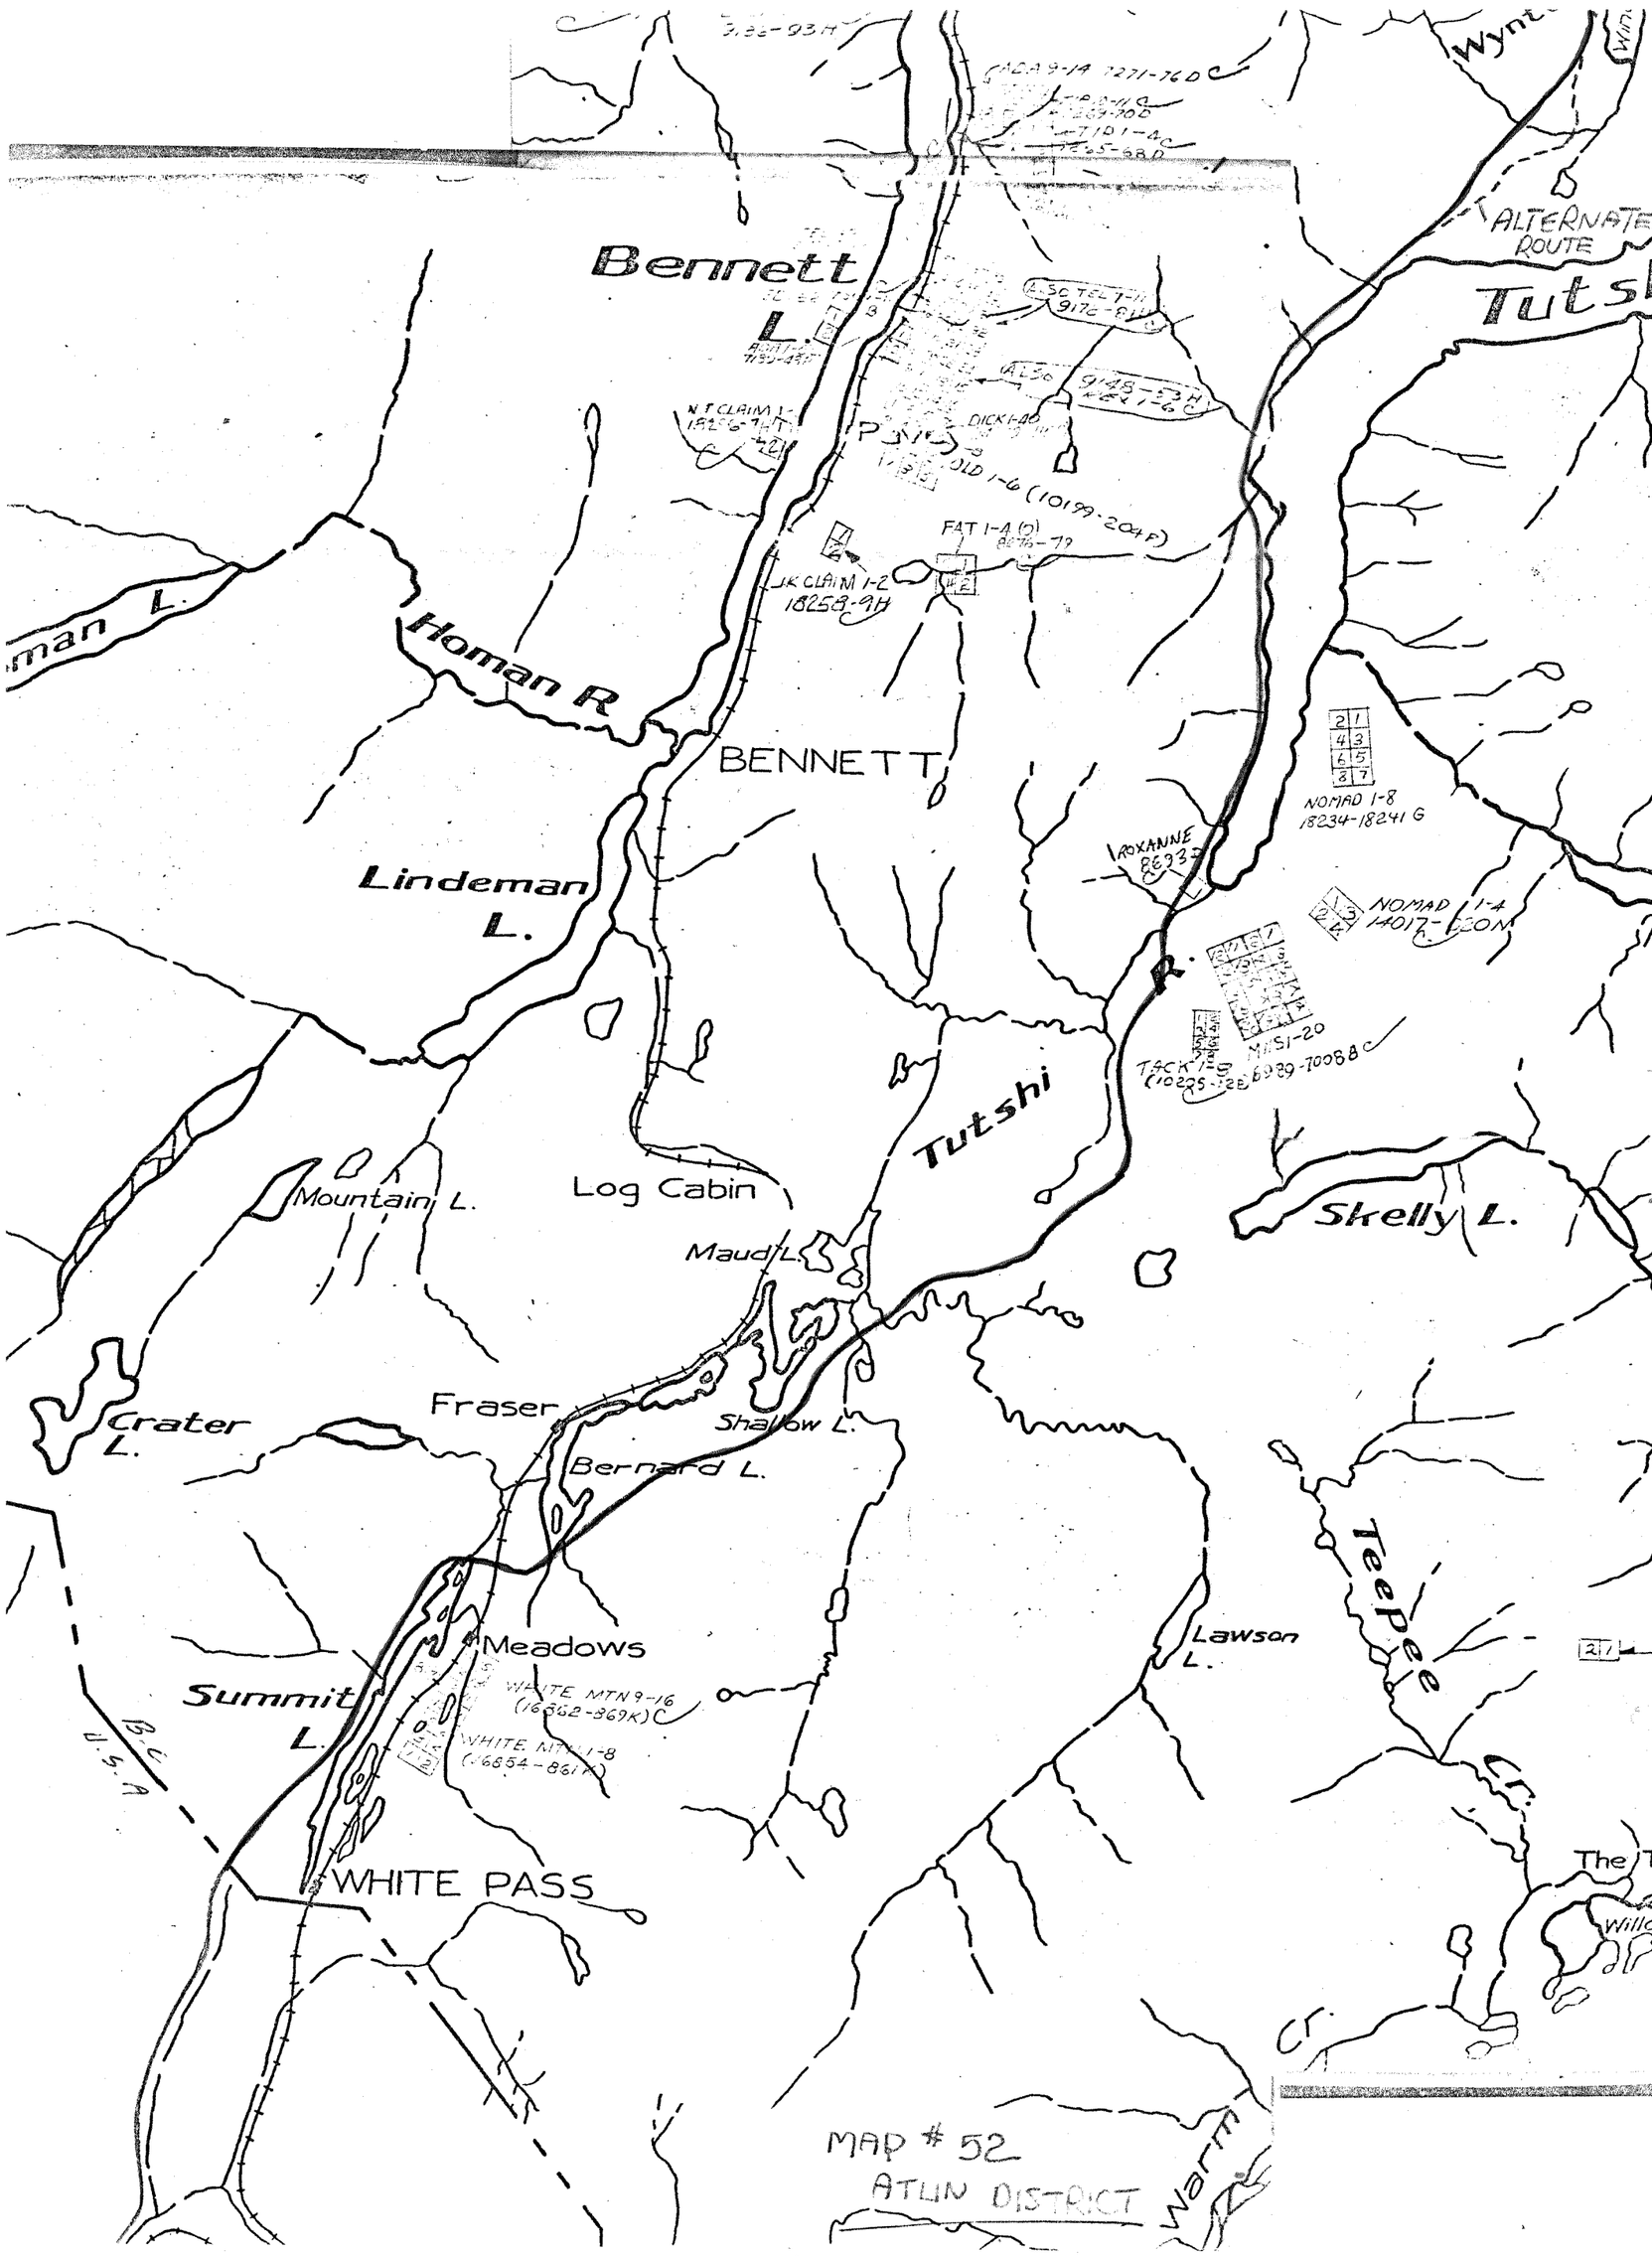
Bennett L.
ALTERNATE ROUTE
Tutsh
NT CLAIM 1-2
18256-9H
DICK 1-10
OLD 1-6 (10199-204F)
FAT 1-4 (2)
JK CLAIM 1-2
18258-9H
Homan R.
BENNETT
NOMAD 1-8
18234-18241 G
ROXANNE
NOMAD 1-4
Lindeman L.
TACK 1-8
MISI-20
Tutshi
Log Cabin
Mountain L.
Maud L.
Skelly L.
Crater L.
Fraser
Shallow L.
Bernard L.
Meadows
WHITE MTN 9-16
(16362-369K)
WHITE MTN 1-8
(16854-861K)
Summit L.
Lawson L.
Teepee Cr.
B.C.
U.S.A.
WHITE PASS
MAP # 52
ATLIN DISTRICT