

ORDER OF THE LIEUTENANT GOVERNOR IN COUNCIL

Order in Council No. 1689, Approved and Ordered AUG. 29, 1985

*[Signature]*  
Lieutenant Governor

Executive Council Chambers, Victoria AUG. 28, 1985

On the recommendation of the undersigned, the Lieutenant Governor, by and with the advice and consent of the Executive Council, orders that section 1 of B.C. Reg. 62/85 is amended by deleting "thence due West 2 160 m, more or less, to the Easterly boundary of Durrance Lake Regional Park;" and substituting "thence Westerly along the Southerly boundary of Section 129, Lake Land District, to its intersection with the Easterly boundary of Section 66, Highland Land District; thence Southerly along the Easterly boundary of Section 66 and Section 79, Highland Land District, to the Southeast corner of Section 79, Highland Land District; thence Westerly along the Southerly boundary of said Section 79, Highland Land District a distance of 650 metres; thence due north to the point of intersection with the southerly boundary of Section 66, Highland Land District; thence Westerly along the said Southerly boundary of Section 66 to the easterly boundary of Durrance Lake Regional Park;"

*[Signature]*  
Minister of Energy, Mines and Petroleum Resources

*[Signature]*  
Presiding Member of the Executive Council

(This part is for the records of the Office of Legislative Counsel, and is not part of the Order.)

Authority under which Order is made:

Act and section:- Mineral Act, section 8; Mining (Placer) Act, section 13

Other (specify):- O.I.C. 456/85

Examined by: Blake Ford *[Signature]*  
(Attorney General examiner)


July 17, 1985

1551/85



**Province of British Columbia**  
**Ministry of Energy, Mines and Petroleum Resources**  
 MINERAL RESOURCES BRANCH-TITLES DIVISION

**HARTLAND ROAD SANITARY LANDFILL SITE**  
 (AMENDED SKETCH)

 

SCALE- 1 : 50 000

CONTOUR INTERVAL- 20 METRES

MINING DIVISION VICTORIA	SKETCH PREPARED BY M. G.
LAND DISTRICT HIGHLAND & LAKE	MINERAL TITLES DRAUGHTING, VICTORIA B.C.
MAP NO. 92B/IIW	DATE 85.06.28