




PROVINCE OF BRITISH COLUMBIA  
MINISTRY OF ENERGY, MINES AND PETROLEUM RESOURCES  
MINERAL TITLES BRANCH

McABEE FOSSIL BEDS

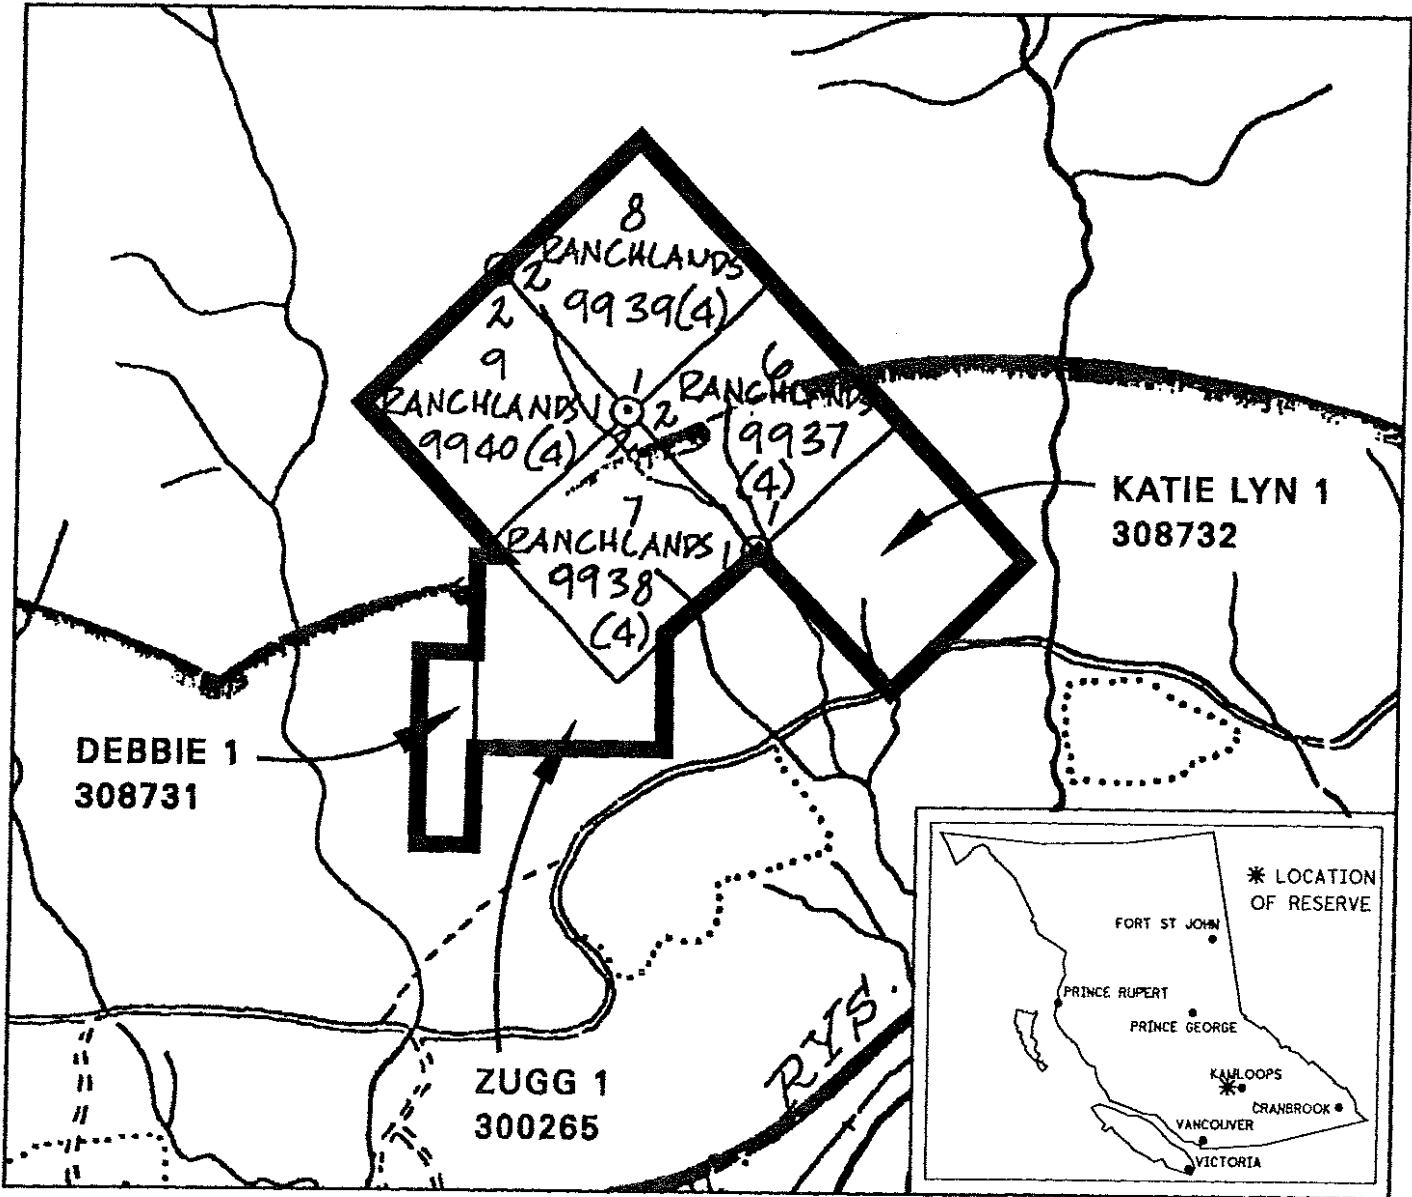

This is a summary sketch of the area shown in black on Mineral Titles Reference Maps (File 12000 01)

LAND DISTRICT: K.D.Y.D.		MINING DIVISION: KAMLOOPS	
MAPS: 092II4E		SCALE 1: 20 000	SKETCH PREPARED BY: DGP