FILE NO. 14280-03-986

PROVINCE OF BRITISH COLUMBIA
MINISTRY OF EMPLOYMENT AND INVESTMENT
MINERAL TITLES BRANCH

DALE

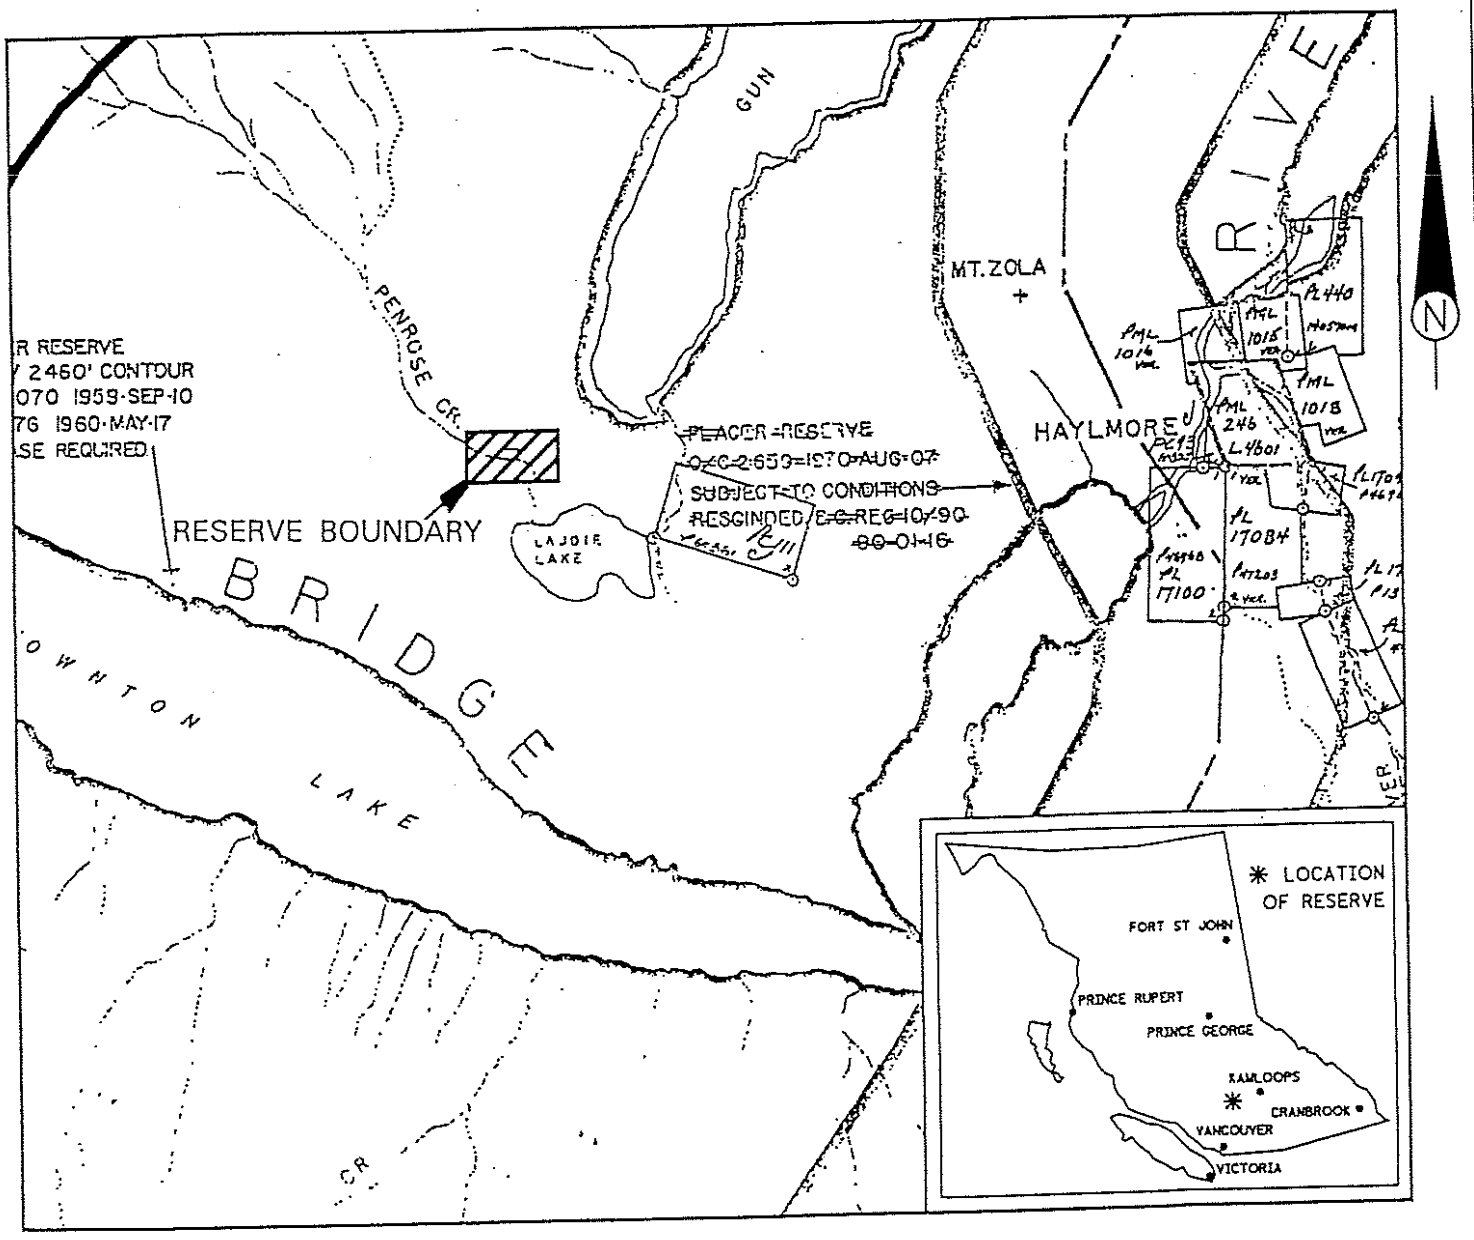

This is a summary sketch of the area shown in black on Mineral Titles Reference Maps (File 12000 01)

LAND DISTRICT: LILLOOET	MINING DIVISION: LILLOOET	
MAPS: 092J15W	SCALE 1:50 000	SKETCH PREPARED BY: JBM