




PROVINCE OF BRITISH COLUMBIA
 MINISTRY OF EMPLOYMENT AND INVESTMENT
 MINERAL TITLES BRANCH

MADSEN

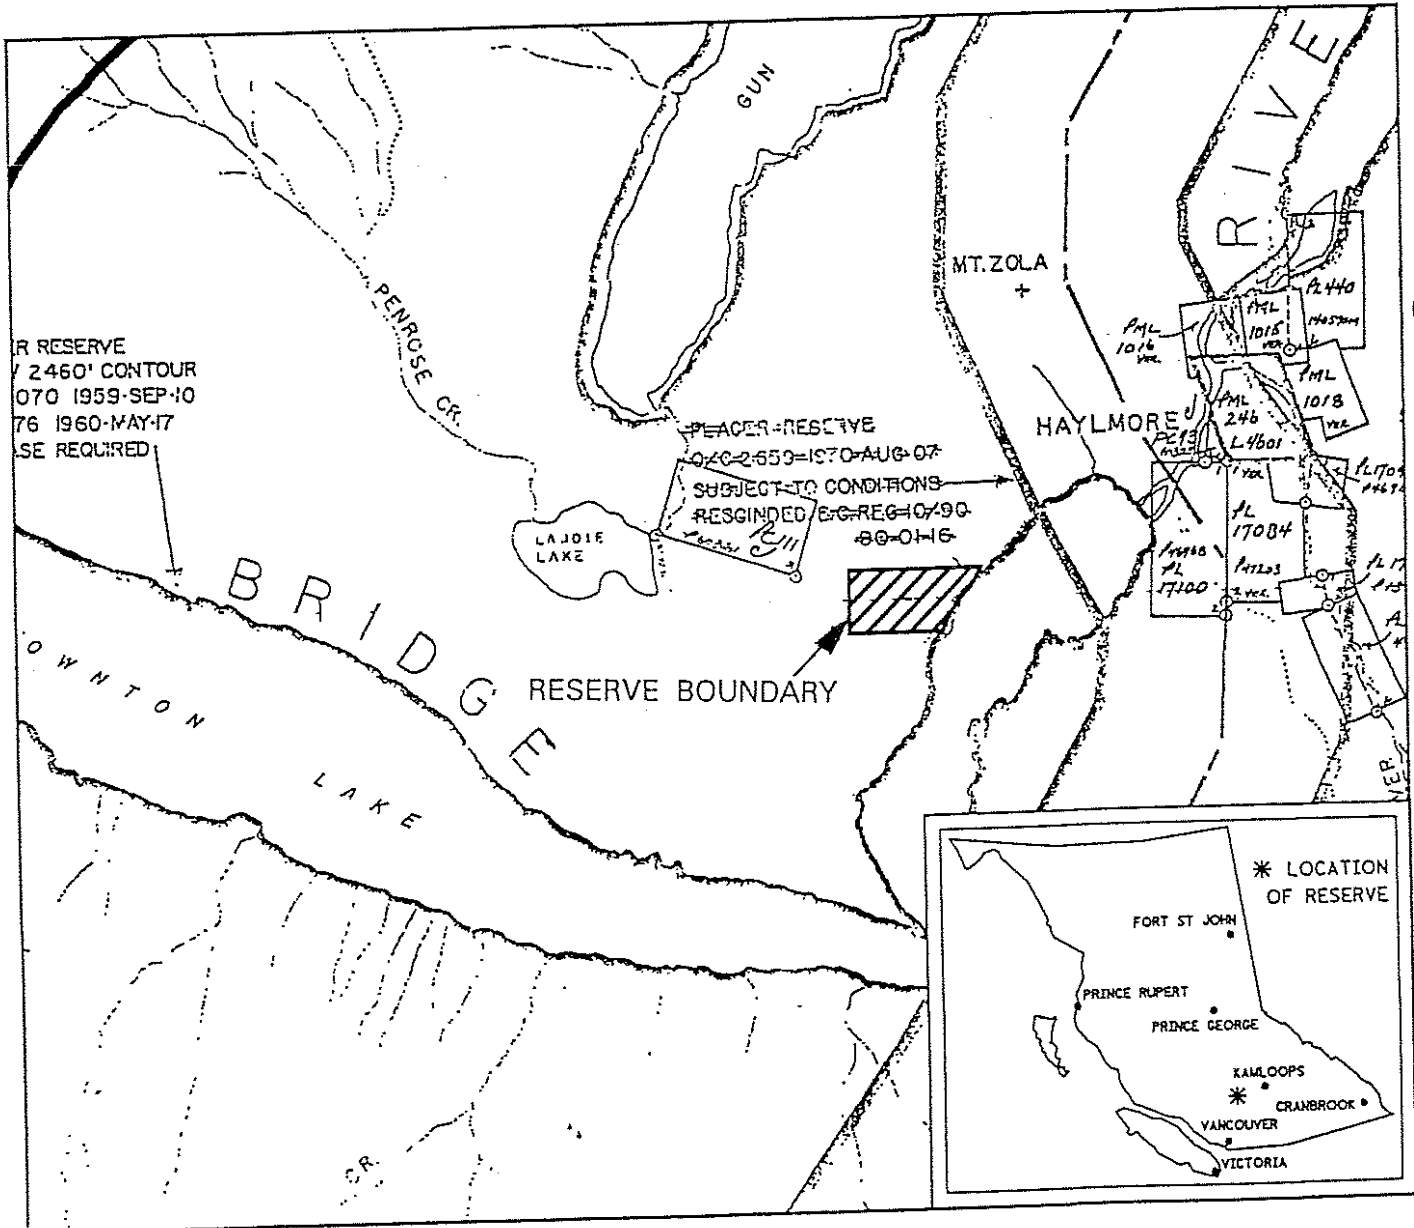

This is a summary sketch of the area shown in black on Mineral Titles Reference Maps (File 12000 01)

LAND DISTRICT: LILLOOET	MINING DIVISION: LILLOOET	
MAPS: 092J15W	SCALE 1: 50 000	SKETCH PREPARED BY: JBM