





6-22A LEH Boundary Change Proposal

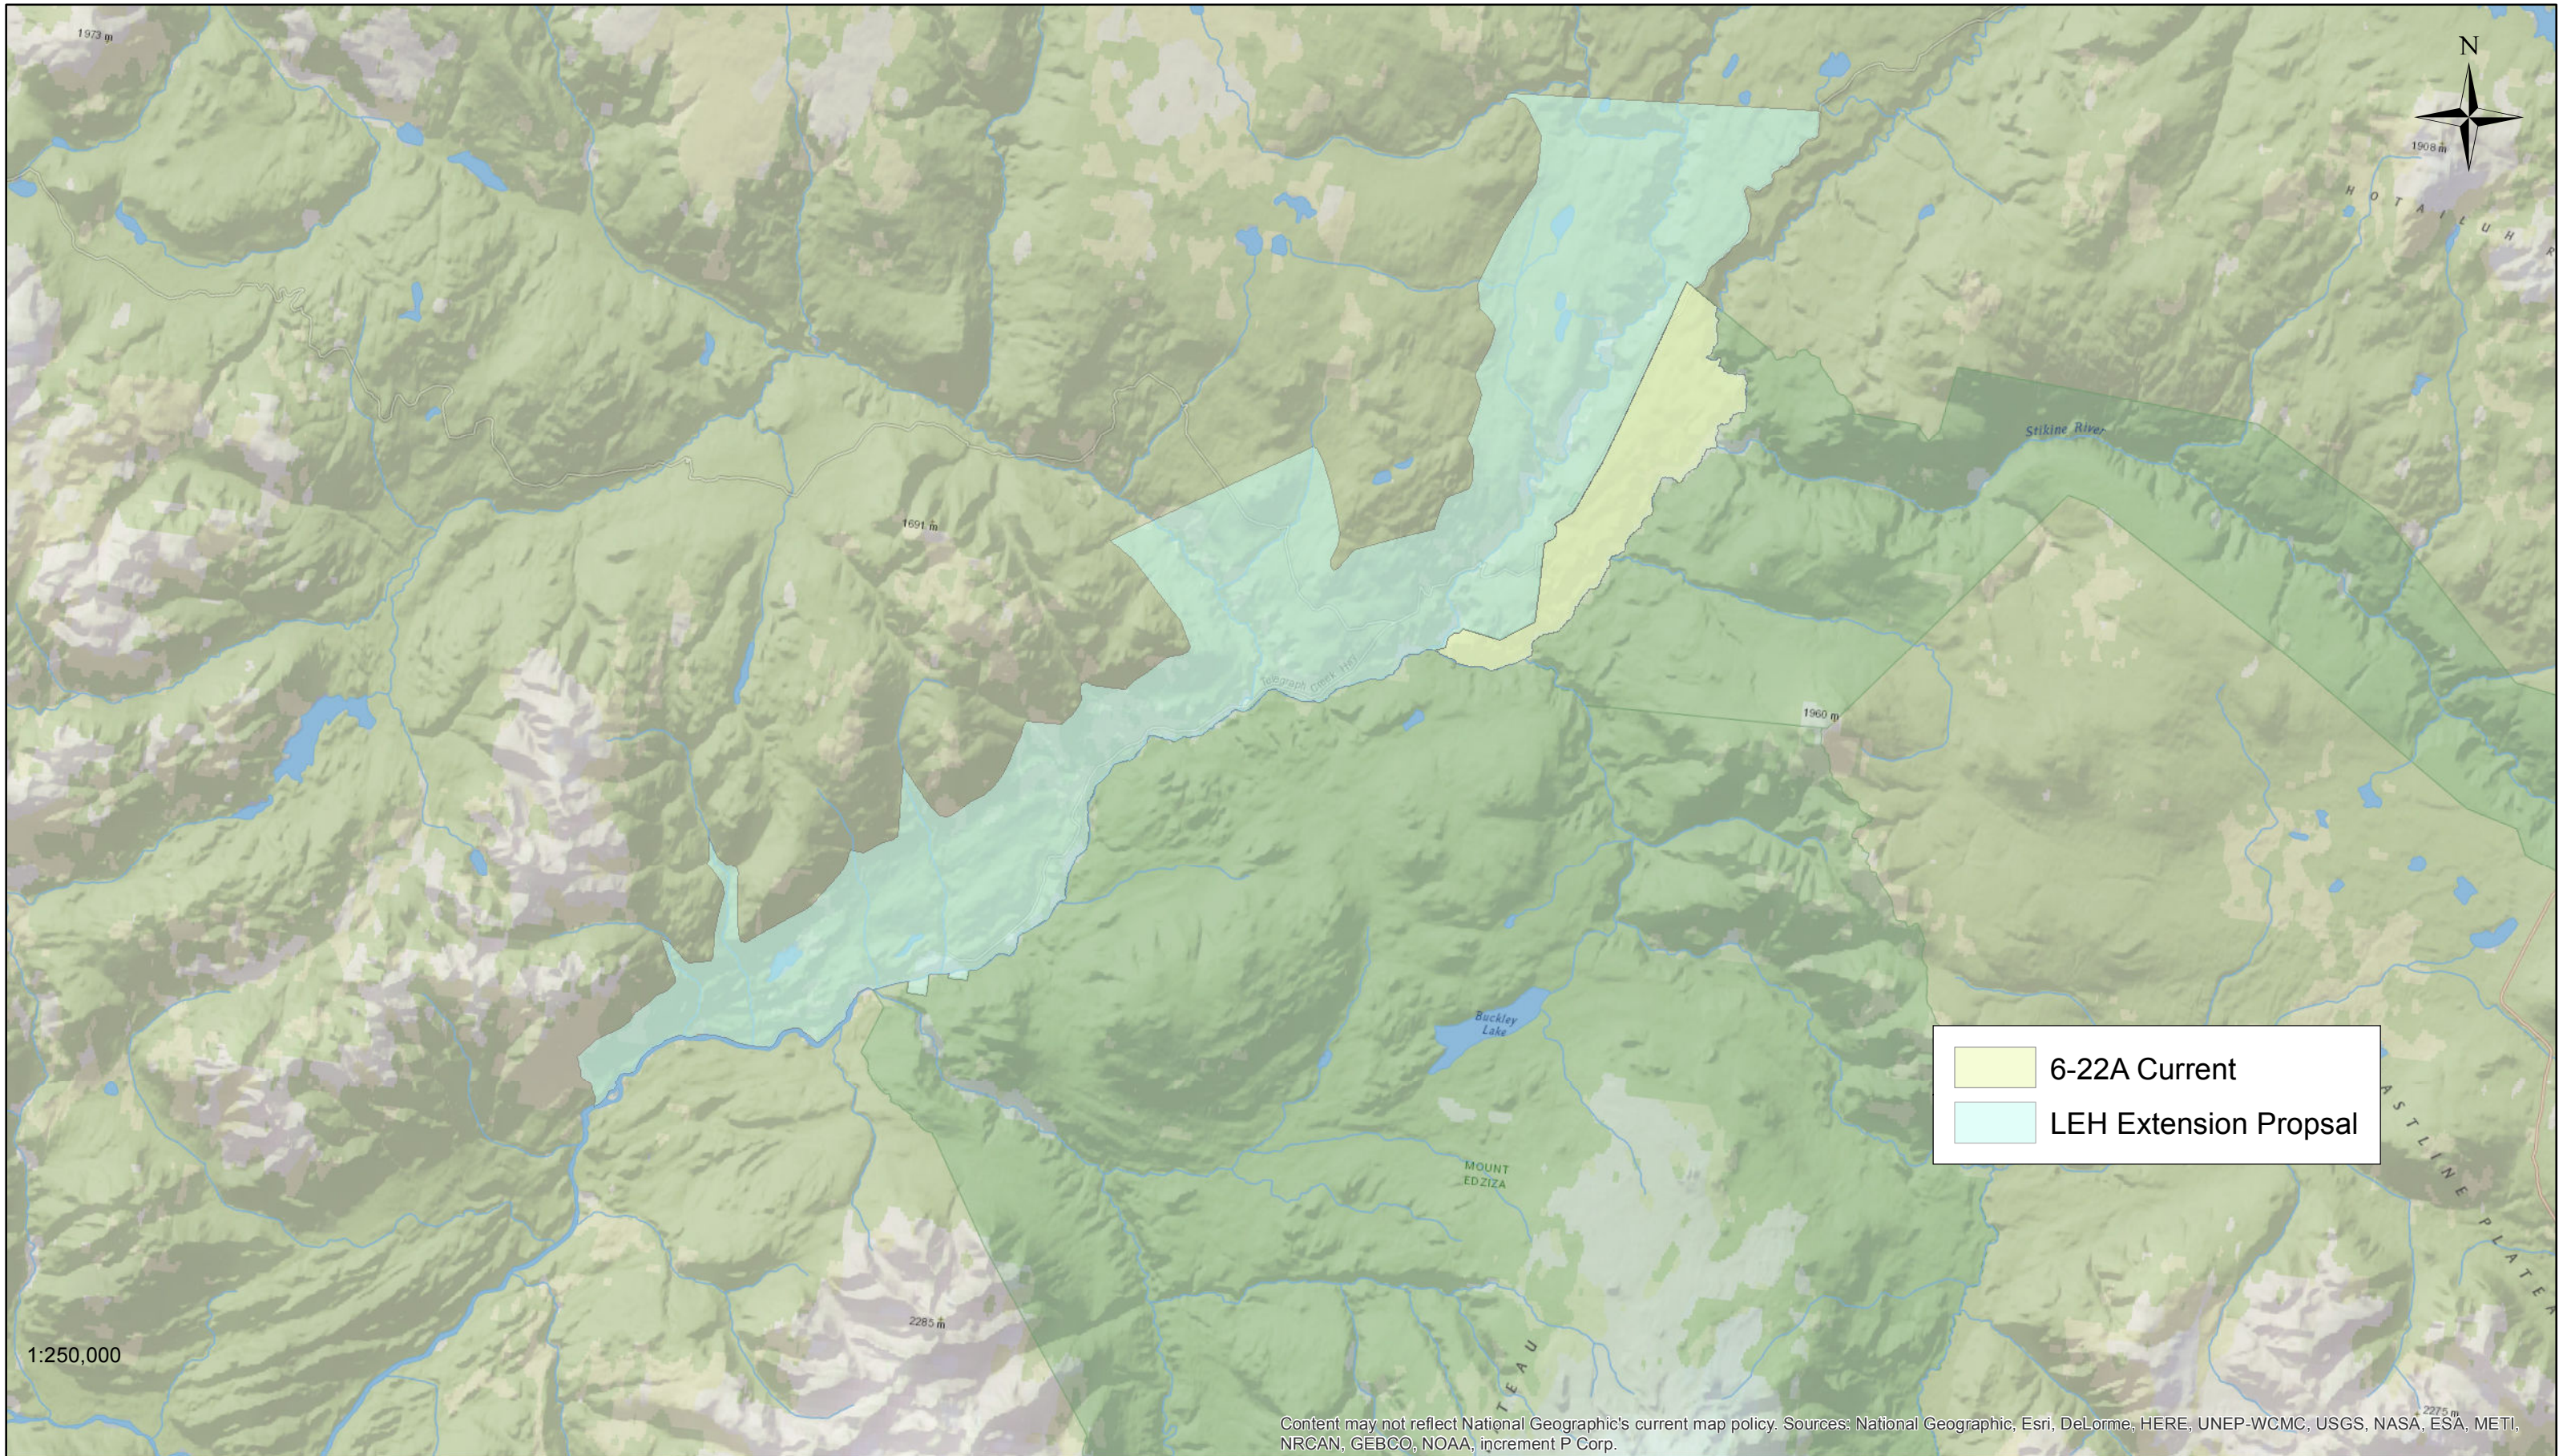

| | |
|---|------------------------|
|  | 6-22A Current |
|  | LEH Extension Proposal |

1:250,000

1:250,000

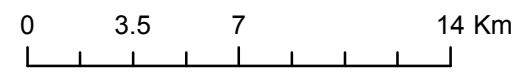

Content may not reflect National Geographic's current map policy. Sources: National Geographic, Esri, DeLorme, HERE, UNEP-WCMC, USGS, NASA, ESA, METI, NRCAN, GEBCO, NOAA, increment P Corp.